IREDELL COUNTY HEALTH DEPARTMENT

STATESVILLE 704-878-5305 MOORESVILLE 704-664-5281

IMPROVEMENT PERMIT / AUTHORIZATION TO CONSTRUCT / OPERATION PERMIT / EXISTING SYSTEM INSPECTION

PERMIT# 077870 PIN# 4863 09 1832 DATE 1-19-99

OWNER OR CONTRACTOR BRENT CASS PHONE: Business _____ Home 539-5091

ADDRESS 283 HOLLAND FARM ROAD UNION GROVE NC 28689

LOCATION I-77N, TL NC 901, TR UNION GROVE RD, TR HOLLAND FARM RD, 0.4 MI. ON (L) PAST ZION LUTHERAN

SUBDIVISION _____ BLOCK / SECTION _____ LOT _____ LOT AREA 25.5 ACRES SITE CLASS PS DESIGN FLOW 600 L.T.A.R. 0.40 GPD/FT²

Septic Tank: 1000 Gallons; STB 760 Date 4-6-99
Pump Tank: _____ Gallons; PT _____ Date _____
Pump Make: _____ Model _____ Serial No. _____
Nitrification Field: No Fields 1 Square Feet 1900 Linear Feet 400
No Lines FOUR Trench Width 36" Max Trench Bottom Depth 36 Gravel Depth 12

[X] New System [ ] Repair System Type: (I) II, III, IV, V, VI
System Description: CONVENTIONAL GRAVITY
Repair System Description: CONV. GRAVITY
Maintenance Agreement Required: [ ] Yes [X] No
[ ] Slab [X] Crawl Space [ ] Basement w/plumbing [ ] Basement wo/plumbing


[ ] House/Mod. Home No. Bedrooms 6
[X] Mobile Home No. Bathrooms 2
[ ] Business No. Employees _____
[ ] Other W/ ADDITION

Water Supply: [X] Individual [ ] Public [ ] Community WELL ACROSS ROAD


Comments:/Conditions:

Comments:/Conditions: (1) 4 BR D/W MH SUBSTITUTED FOR PROPOSED 4 BR ADDITION
(2) SEPTIC TANK WITH MARKER INSTALLED WITH "ZABEL" FILTER AT OUTLET

INITIAL SITE SKETCH

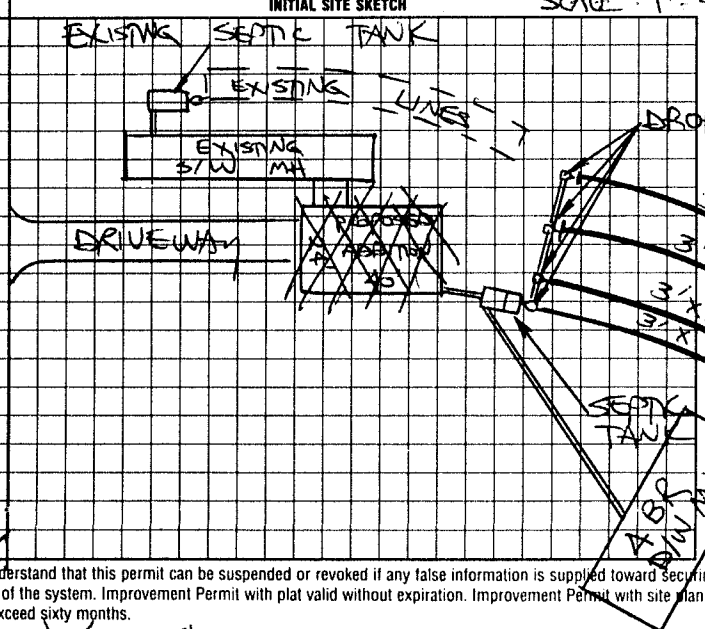

AS BUILT SKETCH

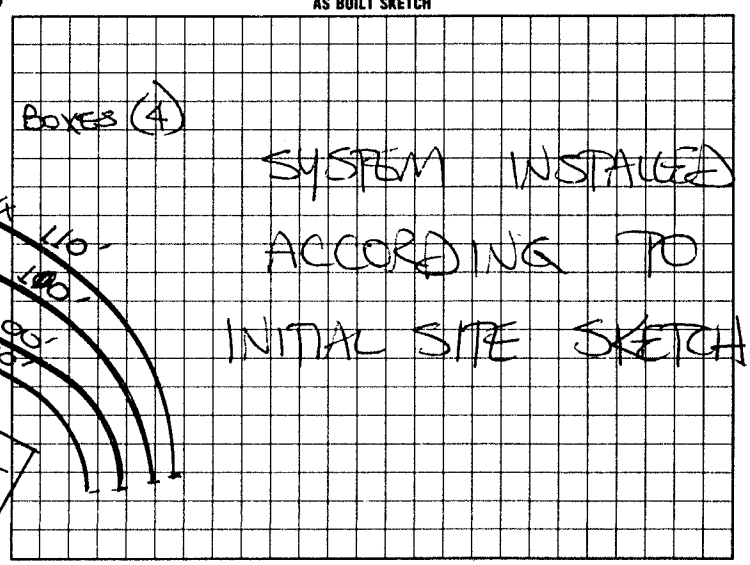

I understand that this permit can be suspended or revoked if any false information is supplied toward securing the permit/any unauthorized changes are made to the site/any unauthorized changes are made in the installation of the system. Improvement Permit with plat valid without expiration. Improvement Permit with site plan valid for sixty months. Authorization to Construct is valid for a period equal to that of Improvement Permit – not to exceed sixty months.

Signed: Brent Cass date 1-19-99 Installed by: RANDY MILLER

Improvement Permit by: STEVE HEDRICK date 1-19-99 Operation Permit by: STEVE HEDRICK date 5-11-99

Authorization to Construct by: STEVE HEDRICK date 1-19-99 Existing System Inspection by: _____ date _____

HEALTH DEPT. COPY: WHITE INSPECTION COPY (FINAL): GREEN OWNER COPY (FINAL): YELLOW INSPECTION COPY (INITIAL): PINK OWNER COPY (INITIAL): GOLD