# ICHD - ENVIRONMENTAL HEALTH DIVISION

Statesville Office (704) 678-5305 Mooresville Office (704) 660-3625 PERMIT # 308960

## SEPTIC: IMPROVEMENT PERMIT / AUTHORIZATION TO CONSTRUCT / OPERATION PERMIT / EXISTING SYSTEM

PIN # 4864022878.599

APPLICANT/OWNER: Harry Hensley APPLICANT ADDRESS: 599 Union Grove Rd

SITE ADDRESS: 599 Union Grove Rd, Union Grove 28689 PHONE: 704-539-5048 ALT. PHONE 704-682-0072

SITE DIRECTIONS: 901 → R Mullis → R stay on Mullis → L Zion Liberty → R Union Grove → on R SAP CONTROLLED: ☐ YES ☒ NO

SUBDIVISION: — SECTION: — LOT # — LOT AREA: 10.89ac DESIGN FLOW: 240gpd L.T.A.R.: repair


| | | | | | | | | | |
|---|---|---|---|---|---|---|---|---|---|
| Septic Tank | 1000 (gal) | STB 760 | Date 6-24 | ☐ New System | ☒ Repair | ☐ Expansion | System Type: I II (III) IV V VI | ☒ Residence | No. Bedrooms 2 |
| Pump Tank | (gal) | PT | Date | System Description: — | | | | ☐ Business | No. Persons 4 |
| Pump Make | Model | | Serial # | Repair System Description: | | | 75% reduction-high capacity | ☐ Other | No. Employees |
| # Nitrification Fields 1 | # Lines 5 | | Linear Ft: 200' | Maintenance Agreement Required: | ☐ YES | ☒ NO | | ☐ Slab | ☒ Crawl Space |
| Trench Width 36" | Trench Bottom Depth (Low side) | | 24" max | Gravel Depth — | ☒ GRAVITY | ☐ PRESSURE | | ☐ Basement w/plumbing | ☐ Basement w/o plumbing |

**Water Supply:** ☒ Private ☐ Public ☐ Community

Comments / Conditions: Install new lines on contour + utilize serial distribution. Install high capacity product with a max trench depth of 24".


Recommend filling old tank with concrete due to location. Earth + dam any area old pipes may impact. Plumb all gray water fixtures into system.

INITIAL SITE SKETCH

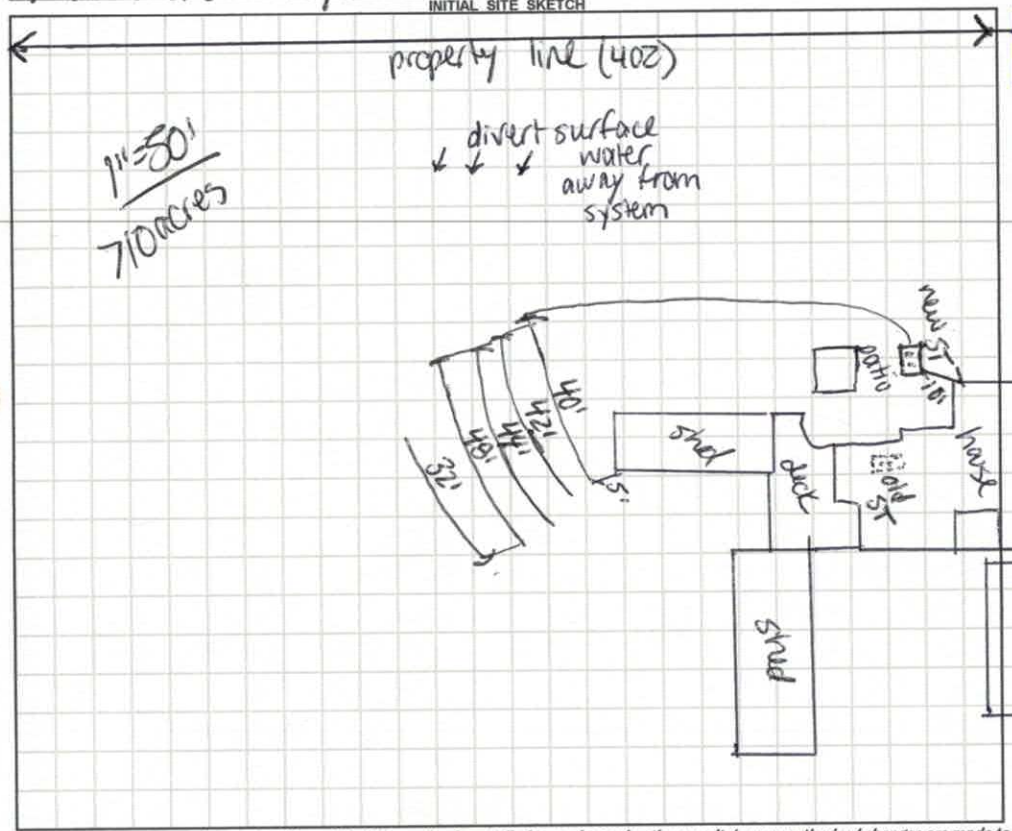


AS-BUILT SKETCH

FOR SEPTIC FINAL INSPECTION CALL: 704-664-3703 between 8am-9am the day the inspection is needed. Be sure to speak with an inspector to confirm your time.

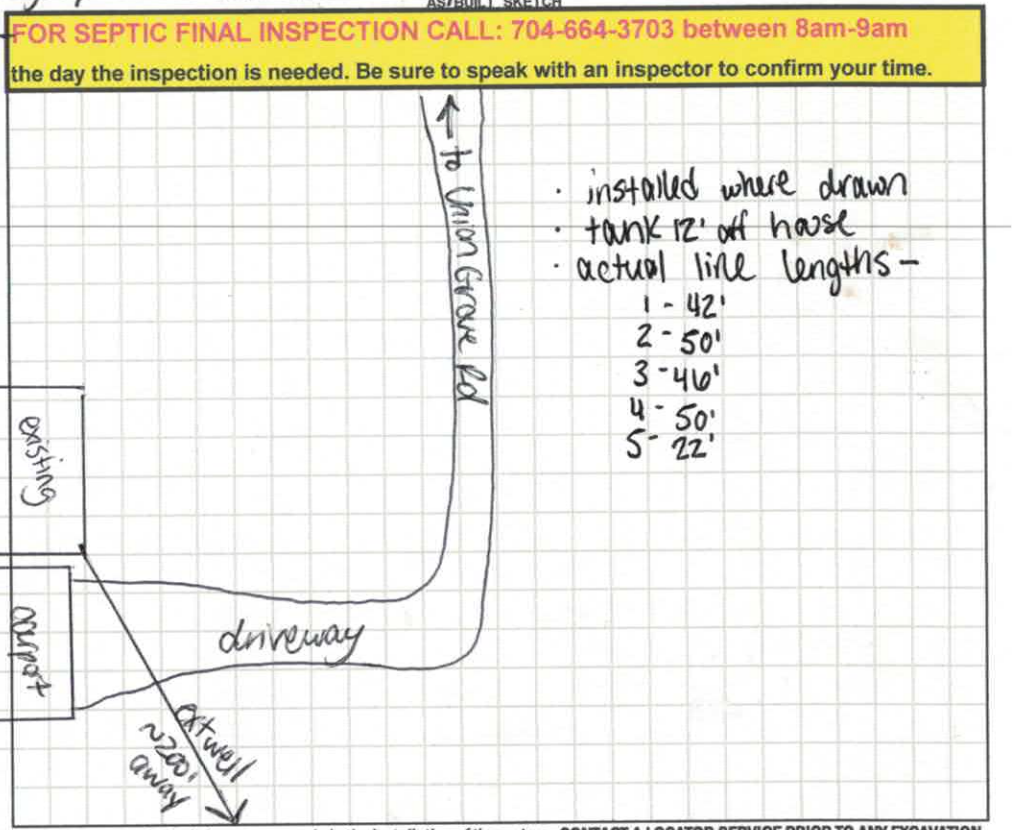


*Permit can be suspended or revoked if any false information is supplied toward securing the permit / any unauthorized changes are made to the site / any unauthorized changes are made in the installation of the system.* **CONTACT A LOCATOR SERVICE PRIOR TO ANY EXCAVATION**

☐ **IMPROVEMENT PERMIT** *with plat valid without expiration.* ☒ **IMPROVEMENT PERMIT** *with site plan valid for 60 mos.* ☒ **AUTHORIZATION TO CONSTRUCT** *valid for period equal to IMPROVEMENT PERMIT--not to exceed 60 mo.*

Owner / Applicant Signature: Harry Hensley Date: 7-16-20 Installed by: Lentz Wastewater

IMPROVEMENT PERMIT by: Carla C. Nicks Date: 7-16-20 OPERATION PERMIT by: Carla C. Nicks Date: 8-10-20

AUTHORIZATION TO CONSTRUCT by: Carla C. Nicks Date: 7-16-20 Existing System Inspected by: Date:

**FOR SEPTIC FINAL INSPECTION: CALL 704-664-3703 between 8am-9am** the day the inspection is needed.

DEPARTMENT OF HEALTH AND HUMAN SERVICES
DIVISION OF PUBLIC HEALTH, ENVIRONMENTAL HEALTH SECTION
ON-SITE WATER PROTECTION BRANCH

Sheet 1 of 1
PROPERTY ID #: 4814022878
COUNTY: Iredell

# SOIL/SITE EVALUATION
## for ON-SITE WASTEWATER SYSTEM
(Complete all fields in full)

OWNER: Harry Hensley
ADDRESS: 599 Union Grove Rd
APPLICATION DATE: 7-10-20
DATE EVALUATED: 7-15-20
PROPOSED FACILITY: 2BR
PROPOSED DESIGN FLOW (.1949): 240gpd
PROPERTY SIZE: 7/10ac
LOCATION OF SITE: 599 Union Grove Rd
PROPERTY RECORDED: Y
WATER SUPPLY: ☐ Private ☐ Public ☒ Well ☐ Spring ☐ Other
EVALUATION METHOD: ☒ Auger Boring ☐ Pit ☐ Cut
TYPE OF WASTEWATER: ☒ Sewage ☐ Industrial Process ☐ Mixed

| PROFILE # | .1940 LANDSCAPE POSITION/ SLOPE % | HORIZON DEPTH (IN.) | SOIL MORPHOLOGY (.1941) .1941 STRUCTURE/ TEXTURE | .1941 CONSISTENCE/ MINERALOGY | OTHER PROFILE FACTORS .1942 SOIL WETNESS/ COLOR | .1943 SOIL DEPTH | .1956 SAPRO CLASS | .1944 RESTR HORIZ | PROFILE CLASS & LTAR |
|---|---|---|---|---|---|---|---|---|---|
| 1 | L 5% | 0-18 | GR SCL | Fr SS SP SLXP | | | | | |
| | | 18-36 | SBK/ABK C | Fr S P SSSP | Y/BS1 | | | | |
| | | 36-48 | ABK/SBK CL | Fr S P SLXP | litho matrix | 48" | - | - | PS |
| | | | | | | | | | |
| | | | | | saprolite | | | | |
| 2 | L 5% | 0-20 | GR SCL | Fr SS SP SLXP | yellowish matrix | | - | - | |
| | | 20-38 | SBK C | Fr S P SLXP | | | | | |
| | | 38-48 | ABK/SBK CL | Fr S P SLXP | Y/BS throughout CL | 48" | | | PS |
| | | | | | | | | | |
| 3 | | | | | | | | | |
| | | | | | | | | | |
| 4 | | | | | | | | | |
| | | | | | | | | | |

| DESCRIPTION | INITIAL SYSTEM | REPAIR SYSTEM |
|---|---|---|
| Available Space (.1945) | | 2066' |
| System Type(s) | | 2570-HC |
| Site LTAR | | Repair |

OTHER FACTORS (.1946): N/A
SITE CLASSIFICATION (.1948): PS
EVALUATED BY: C. Nicks
OTHER(S) PRESENT: H. Snow, B. White

COMMENTS:

# LEGEND

*use the following standard abbreviations*

| LANDSCAPE POSITION | GROUP | SOIL TEXTURE | CONVENTIONAL .1955 LTAR* | LPP .1957 LTAR* | MINERALOGY/ CONSISTENCE | STRUCTURE |
|---|---|---|---|---|---|---|
| GC (Concave Slope) | I | S (Sand) | 1.2 - 0.8 | 0.6 - 0.4 | SEXP (Slightly Expansive) | G (Single Grain) |
| CV (Convex Slope) | | LS (Loamy Sand) | | | EXP (Expansive) | M (Massive) |
| D (Drainage Way) | | | | | | CR (Crumb) |
| DS (Debris Slump) | II | SL (Sandy Loam) | 0.8 - 0.6 | 0.4 - 0.3 | | GR (Granular) |
| FP (Flood Plain) | | L (Loam) | | | | SBK (Subangular Blocky) |
| FS (Foot Slope) | | | | | | ABK (Angular Blocky) |
| H (Head Slope) | III | Si (Silt) | 0.6 - 0.3 | 0.3 - 0.15 | | PL (Platy) |
| L (Linear Slope) | | SiCL (Silty Clay Loam) | | | | PR (Prismatic) |
| N (Nose Slope) | | CL (Clay Loam) | | | | |
| R (Ridge) | | SCL (Sandy Clay Loam) | | | **MOIST** | **WET** |
| S (Shoulder Slope) | | SiL (Silt Loam) | | | | |
| T (Terrace) | | | | | VFR (Very Friable) | NS (Non-sticky) |
| | IV | SC (Sandy Clay) | 0.4 - 0.1 | 0.2 - 0.05 | FR (Friable) | SS (Slightly Sticky) |
| | | SiC (Silty Clay) | | | FI (Firm) | S (Sticky) |
| | | C (Clay) | | | VFI (Very Firm v. Very Sticky) | VS (Very Sticky) |
| | | O (Organic) | None | None | EFI (Extremely Firm) | NP (Non-plastic) |
| | | | | | | SP (Slightly Plastic) |
| | | | | | | P (Plastic) |
| | | | | | | VP (Very Plastic) |

*Adjust LTAR due to depth, consistence, structure, soil wetness, landscape, position, wastewater flow and quality.

***NOTES***


| | |
|---|---|
| *HORIZON DEPTH* | In inches below natural soil surface |
| *DEPTH OF FILL* | In inches from land surface |
| *RESTRICTIVE HORIZON* | Thickness and depth from land surface |
| *SAPROLITE* | S(suitable) or U(unsuitable) |
| *SOIL WETNESS* | Inches from land surface to free water or inches from land surface to soil colors with chroma 2 or less - record Munsell color chip designation |
| *CLASSIFICATION* | S (Suitable), PS (Provisionally Suitable), or U (Unsuitable) |

Evaluation of saprolite shall be by pits.

Long-term Acceptance Rate (LTAR): gal/day/ft$^2$

0-17 SCL
recommend (5-14" Sand fore

**Show profile locations and other site features (dimensions, reference or benchmark, and North).**

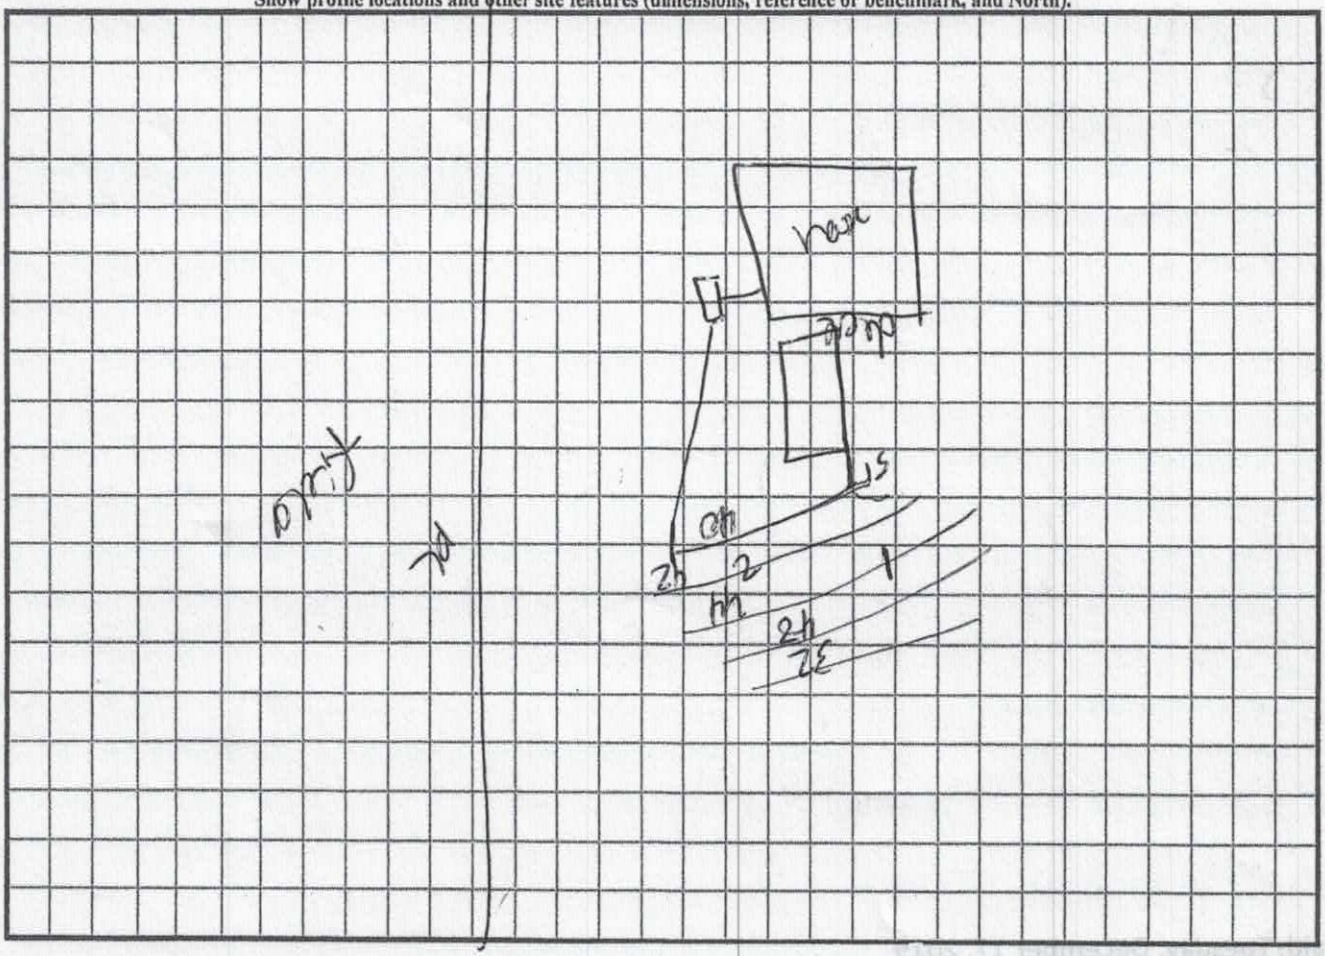

RECEIVED JUL 10 2020

AP-308960

# IREDELL COUNTY DEPARTMENT of ENVIRONMENTAL HEALTH

*APPLICATION FORM*

**Application For:** ( ) New Well Permit ( ) Well Repair Permit ( ) Well Abandonment
(✓) Septic Improvement Permit ( ) Authorization to Construct ( ) Existing System Inspection ( ) Septic System Repair

*THE ABOVE PERMIT DOCUMENTS WILL BECOME INVALID IF INFORMATION PROVIDED ON THIS APPLICATION IS FALSIFIED OR CHANGED, OR IF THE SITE IS ALTERED. THE IMPROVEMENT PERMIT IS VALID FOR EITHER 60 MONTHS OR WITHOUT EXPIRATION DEPENDING UPON DOCUMENTATION SUBMITTED. APPLICATION WITH SITE PLAN 60 MONTHS, APPLICATION WITH COMPLETE, SCALED PLAT WITHOUT EXPIRATION. SEE 15A NCAC 18A .1937(f) FOR DETAILS.*

**Page 2: *Site Plan Worksheet* form MUST accompany this application**

The following optional attachments may also be submitted: ( ) Survey Plat, scaled no more than 1 inch = 60 feet
*Place an (X) beside whichever is submitted if applicable* ( ) Custom Site Plan, scaled no more than 1 inch = 60 feet

**Applicant Information:** (PRINT CLEARLY)

Applicant Name: Harry Hensley Address: 599 Union Grove Rd Zip: 28689
Applicant Email: Harry Hensley Jr@G.Mail Phone: 704 539 5048 Alt. Phone: 704 682 0072
Owner Name: Diana Harry Hensley Address: Union Grove Zip: 28689
Owner Email: Harry HensleyJr@G.Mail Phone: 704 539 5048 Alt. Phone: 704 682 0072

**Property Information:**

Street Address: 599 Union Grove Rd
Subdivision Name: _____ Section/Phase: _____ Lot Number: _____
Driving Directions: _____

**Site Development Information:** *(check or complete ALL that apply*

(✓) New Single Family Residence Maximum Number of Bedrooms: 2
( ) New Multi-Family Residence Maximum Number of Occupants: 2
( ) Accessory Building ( ) Swimming Pool
( ) Bedroom(s) Addition ( ) Other Addition/Structure: _____
(✓) Repair to failing septic system ✓ Tank ✓ Drain lines Describe Problem: _____
Non-Residential Site Development: Type of Business: _____
Square Footage of Building: _____ Max. Number of Employees: _____ Max. Number of Seats/Beds/Other: _____

**CHECK FOUNDATION TYPE**

( ) Crawl Space Foundation
( ) Concrete Slab Foundation
( ) Basement with Plumbing
( ) Basement without Plumbing

**Water Supply:** ( ) Replacement Well – Reason: _____
( ) Multi-connection Well Number of Houses: _____ Number of Persons: _____
( ) New Well (✓) Existing Well ( ) Community Well ( ) City Water ( ) Other Public Water

**Desired Septic System Type:** *(you may rank in order of preference)* Year existing system installed: _____
(✓) No Preference ( ) Alternative ( ) Conventional ( ) Innovative ( ) Modified Conventional ( ) Other: _____

**Please answer the following to the best of your ability:**

( ) Yes (✓) No Does the site contain any jurisdictional wetlands?
( ) Yes (✓) No Is any non-domestic sewage (i.e. industrial) to be generated?
( ) Yes (✓) No Is the site subject to approval by any other public agency?

No permit in DB. Built in 1941.

*I have read this application and certify that the information provided herein is true, complete, and correct. Authorized county and state officials are granted right of entry to conduct necessary inspections to determine compliance with applicable laws and rules. I understand that I am solely responsible for the proper identification and labeling of all property lines and corners and making the site accessible so that a complete site evaluation can be performed.*

**Signature:** Harry Hensley 7-10-20
Property owner or owner's legal representative signature (SIGNATURE REQUIRED) DATE


# IREDELL COUNTY DEPARTMENT of ENVIRONMENTAL HEALTH

***SITE PLAN WORKSHEET***

**SEE THE "SAMPLE SITE PLAN" BELOW.** ***INCOMPLETE SITE PLANS WILL BE RETURNED TO YOU FOR COMPLETION AND MAY RESULT IN A DELAY IN THE ISSUANCE OF YOUR SEPTIC SYSTEM OR WELL PERMIT!!!***

**Place an (X) beside each item as you complete the site plan:**

( ) Property Line measurements are clearly identified
( ) All proposed structures are indicated
( ) Front and side setbacks from property line
( ) Preferred driveway location
( ) Preferred well location
( ) Preferred septic system location
( ) North arrow, or other sufficient indicator of direction

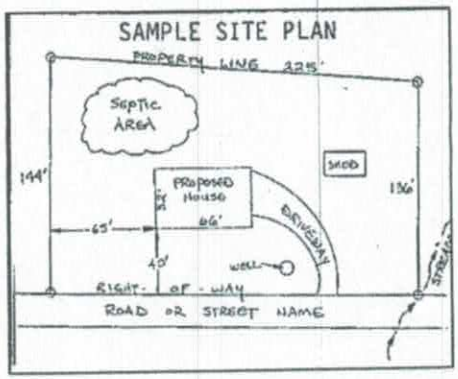



**Circle N/A on the following if appropriate:**

| | |
|---|---|
| Location of septic systems and wells within 100' of your property | N/A |
| Location of easements and rights of ways on your property | N/A |
| Location of any designated wetlands on the property | N/A |

## USE THIS SPACE TO DRAW YOUR SITE PLAN

***Show: proposed house or business footprint, wells, water lines, patios, pools and decks, and any other item that will occupy space on the site***

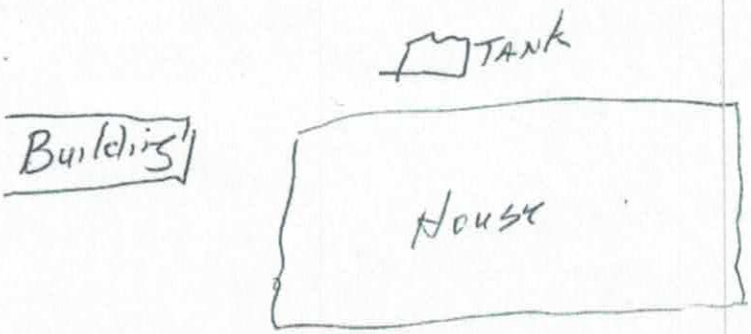


**Signature:** _____ 7-10-20

**Property owner or owner's legal representative signature (SIGNATURE REQUIRED)** **DATE**

# IREDELL COUNTY DEPARTMENT OF ENVIRONMENTAL HEALTH

## DOCUMENTATION TO AUTHORIZE AN OWNER'S LEGAL REPRESENTATIVE

*(Check and sign only ONE of the options below)*

☐ **1. * APPLICANT AND OWNER ARE THE SAME. * (*Sign here*)** Harry Hendy

Applications for permits require the "signature of the owner or owner's legal representative" (15A NCAC 18A .1937). If the owner does not sign the application himself or herself, they can submit any one of the following documents to designate their legal representative: *Power of Attorney; Real Estate Contract; Estate executor; Bankruptcy trustee; Court ordered guardianship*

In the absence of the above documentation, the property owner may provide the local health department with documentation that designates a legal representative. A property owner may:

Complete this form to document his or her legal representative, or provide his or her own form that contains the information in this form. If there are multiple property owners, then all property owners must sign the form that designates a legal representative.

**By signing a form that designates a legal representative for purposes of 15A NCAC 18A .1937, the property owner authorizes that representative to act on their behalf in matters pertaining to the application and permitting process, including signing or receiving any application, document or permit. The owner retains full responsibility to meet all permit conditions specified by the local health department.**


I do hereby authorize **(print legal representative/company name)**

_____, _____, to act as an agent on my behalf in applying for/signing/obtaining any of the documents described below.

- Application for Improvement Permit (IP) / Authorization to Construct (AC)
- Improvement Permit (IP) / Authorization to Construct (AC)
- Application for soil-site evaluation (new/repair)
- Application/permit for private drinking water well/well abandonment
- Application for Compliance Inspection

I agree to abide by all decisions and/or conditions between the legal representative acting on my behalf and the Iredell County Department of Public Health, Environmental Health Division.

Harry Hendy
Signature of Owner(s)

7-10-20
Date

**Mooresville - Environmental Health**
ronda.hart@co.iredell.nc.us
Fax: 704-662-3239
610 E. Center Avenue, Mooresville, NC 28115

**Statesville - Environmental Health**
adrienne.shea@co.iredell.nc.us
Fax: 704-871-3483
349 N. Center Street, Statesville, NC 28677