Phillip + Tonda McDaniels

IREDELL COUNTY HEALTH DEPARTMENT

STATESVILLE 704-878-5305 MOORESVILLE 704-664-5281

IMPROVEMENT PERMIT / AUTHORIZATION TO CONSTRUCT / OPERATION PERMIT / EXISTING SYSTEM INSPECTION

578 Union Grove Rd - Union Grove

PERMIT# 137125 PIN# 4864033439 DATE 8-7-06

OWNER OR APPLICANT David M. Perry Building Co. PHONE: Business 704-539-5169 Home

ADDRESS Union Grove Rd.

LOCATION I-77 N to exit 65, left Hwy 901, right on Union Grove Loop Rd, go through cross roads, property on left

SUBDIVISION ~~Not~~ Woodburn Acres BLOCK / SECTION LOT 1 LOT AREA 1.492 Ac SITE CLASS. PS DESIGN FLOW 360 L.T.A.R. .3

Septic Tank: 1000 Gallons; STB Date

Pump Tank: Gallons; PT Date

Pump Make: Model Serial No.

Nitrification Field: No Fields 1 Square Feet 1200 Linear Feet 300

No Lines 3 Trench Width ~~18"~~ 36" Max Trench Bottom Depth 36" Gravel Depth n/a

☒ New System ☐ Repair ☐ Expansion System Type: I II III IV V VI

System Description: 25% Reduction System/Conv.

Repair System Description: 25% Reduction System

Maintenance Agreement Required: ☐ Yes ☒ No

☒ Gravity ☐ Pressure

☒ House/Mod. Home No. Bedrooms 3

☐ Mobile Home No. Persons

☐ Business No. Employees

☐ Other


Water Supply: ☒ Individual ☐ Public ☐ Community

☐ Slab ☐ Crawl Space ☐ Basement w/plumbing ☐ Basement wo/plumbing


Comments:/Conditions: Conventional @ 400' total line length
or 25% Reduction @ 300' total line length

Comments:/Conditions:

INITIAL SITE SKETCH

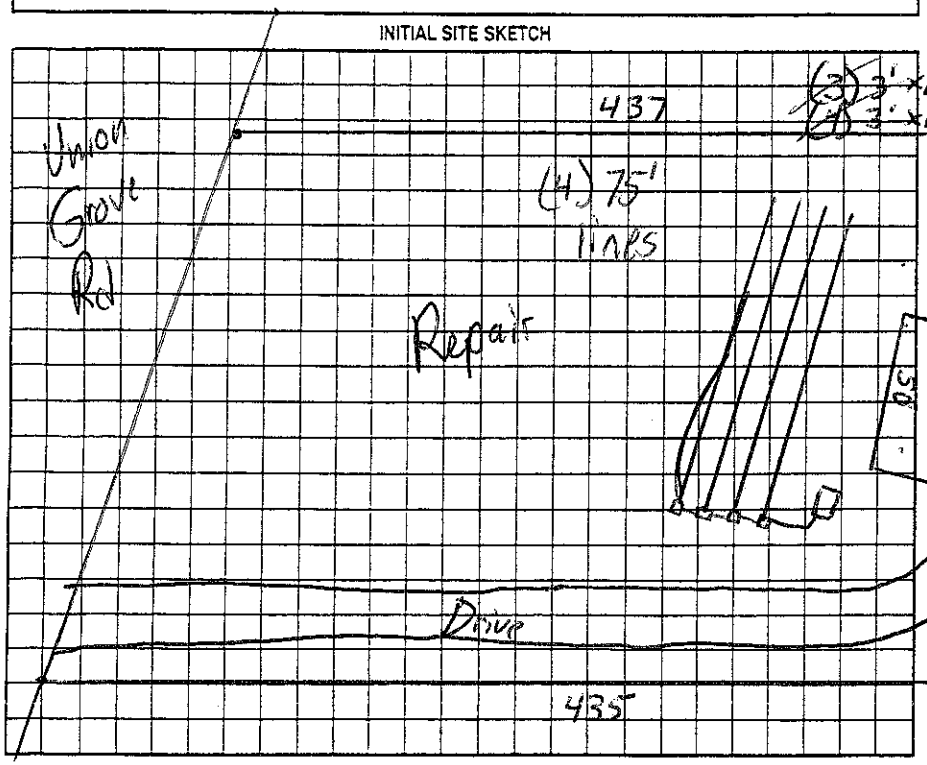

AS BUILT SKETCH

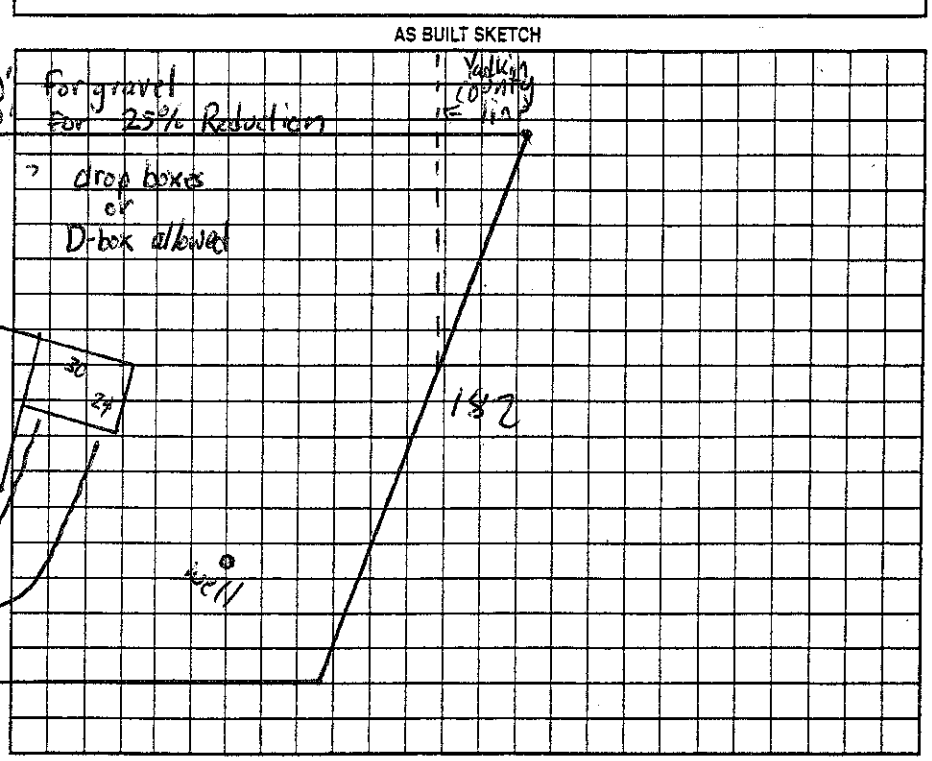

Permit can be suspended or revoked if any false information is supplied toward securing the permit/any unauthorized changes are made to the site/any unauthorized changes are made in the installation of the system. Improvement Permit with plat valid without expiration ☐ Improvement Permit with site plan valid for sixty months ☐ Authorization to Construct is valid for a period equal to that of Improvement Permit – not to exceed sixty months.

Signed: David M. Perry date 8-9-06

Improvement Permit by: date 8-7-06

Authorization to Construct by: date 8-7-06

Installed by: Tommy Frye

Operation Permit by: date 2-4-07

Existing System Inspection by: date

HEALTH DEPT. COPY: WHITE OWNER COPY (FINAL): YELLOW OWNER COPY (INITIAL): PINK