IREDELL COUNTY HEALTH DEPARTMENT

STATESVILLE 704-878-5305 MOORESVILLE 704-664-5281

IMPROVEMENT PERMIT / AUTHORIZATION TO CONSTRUCT / OPERATION PERMIT / EXISTING SYSTEM INSPECTION

PERMIT# 086935 PIN# 4864 40 9505 DATE 1-7-00

OWNER OR CONTRACTOR TOMMY YORK PHONE: Business Home 539-5233

ADDRESS 288 UNION GROVE RD, UNION GROVE, NC 28689

LOCATION I-77 N, TL NC901, TR UNION GROVE RD, LOT ON LEFT BEFORE TRIVETTE ROAD,

SUBDIVISION BLOCK / SECTION LOT LOT AREA 15 ACRES SITE CLASS PS DESIGN FLOW 240 L.T.A.R. 0.3 GPD/FT²

Septic Tank: 1000 Gallons; STB 312 Date 11-17-99

Pump Tank: Gallons; PT Date

Pump Make: Model Serial No.

Nitrification Field: No Fields 1 Square Feet 810 Linear Feet 270

No Lines THREE Trench Width 36" Max Trench Bottom Depth 36"

☑ New System ☐ Repair System Type: I (II) III. IV. V. VI

System Description: CONVENTIONAL GRAVITY

Repair System Description: CONVENTIONAL PUMP

Maintenance Agreement Required: ☐ Yes ☑ No

Gravel Depth 12"

☐ House/Mod. Home ☐ Mobile Home ☐ Business ☐ Other

No. Bedrooms 2 No. Bathrooms 2 No. Employees


☐ Slab ☐ Crawl Space ☐ Basement w/plumbing ☐ Basement wo/plumbing

Water Supply: ☑ Individual ☐ Public ☐ Community WELL


Comments:/Conditions:

Comments:/Conditions: ① SEPTIC TANK WITH RISERS AND MARKER INSTALLED USING "POLYLOK" FILTER ② UPPER LINE INSTALLED TOO DEEP AT 42"

SCALE: 1"=40' INITIAL SITE SKETCH

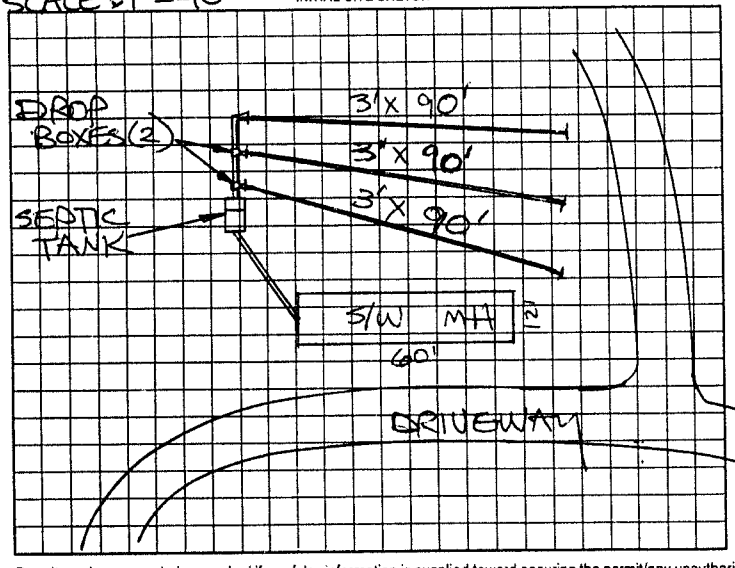

AS BUILT SKETCH

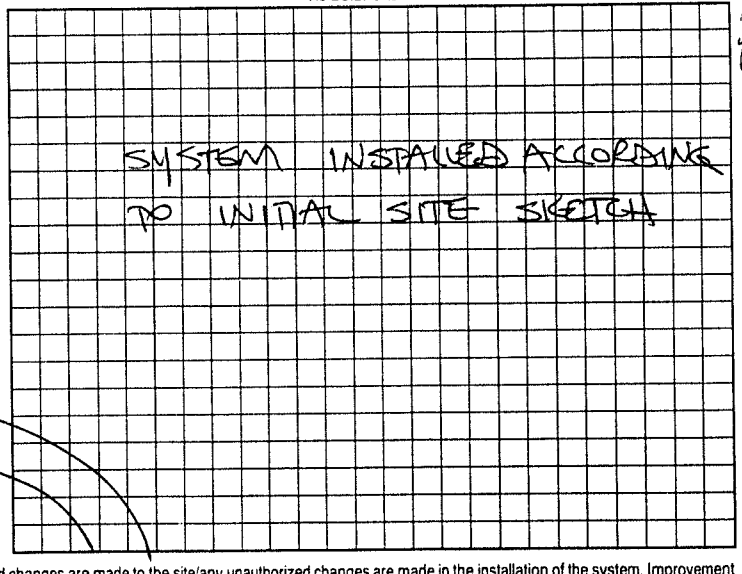

Permit can be suspended or revoked if any false information is supplied toward securing the permit/any unauthorized changes are made to the site/any unauthorized changes are made in the installation of the system. Improvement Permit with plat valid without expiration. Improvement Permit with site plan valid for sixty months. Authorization to Construct is valid for a period equal to that of Improvement Permit – not to exceed sixty months.

Signed: Tommy K. York date 1-7-00 Installed by: TUCKER'S HAULING & GRADING

Improvement Permit by: STEVE HEDRICK date 1-7-00 Operation Permit by: STEVE HEDRICK date 2-24-00

Authorization to Construct by: STEVE HEDRICK date 1-7-00 Existing System Inspection by: date

HEALTH DEPT. COPY: WHITE OWNER COPY (FINAL): YELLOW OWNER COPY (INITIAL): PINK

BACK OF PAGE