IREDELL COUNTY HEALTH DEPARTMENT

STATESVILLE 704-878-5305 MOORESVILLE 704-664-5281

IMPROVEMENT PERMIT / AUTHORIZATION TO CONSTRUCT / OPERATION PERMIT / EXISTING SYSTEM INSPECTION

PERMIT# 133359 PIN# 4864401505 DATE 1-26-09

OWNER OR CONTRACTOR Tommy Haigh PHONE: Business _____ Home _____

ADDRESS 288 Union Grove RD York SC 29689 7283

LOCATION 77 N - exit 5 (R) — (R) Manus RD (L) Main (L) Signet (L) Union Grove RD on Right

SUBDIVISION _____ BLOCK / SECTION _____ LOT _____ LOT AREA BAC SITE CLASS. 3 DESIGN FLOW 240 L.T.A.R. 13

Septic Tank: 1000 Gallons; STB _____ Date _____

Pump Tank: _____ Gallons; PT _____ Date _____

Pump Make: _____ Model _____ Serial No. _____

Nitrification Field: No Fields ___ Square Feet 810 Linear Feet 270

No Lines 2 Trench Width 36" Max Trench Bottom Depth 36" Gravel Depth 12

☐ New System ☐ Repair System Type: I, II, III, IV, V, VI

System Description: Gravel - Exist

Repair System Description: _____

Maintenance Agreement Required: ☐ Yes ☐ No

☐ House/Mod. Home No. Bedrooms 2

☑ Mobile Home No. Bathrooms ___

☐ Business No. Employees ___

☐ Other _____

☐ Slab ☑ Crawl Space ☐ Basement w/plumbing ☐ Basement wo/plumbing

Water Supply:
☑ Individual
☐ Public
☐ Community


Comments:/Conditions:

Well 100+ around Chicken House

Comments:/Conditions:

INITIAL SITE SKETCH

AS BUILT SKETCH

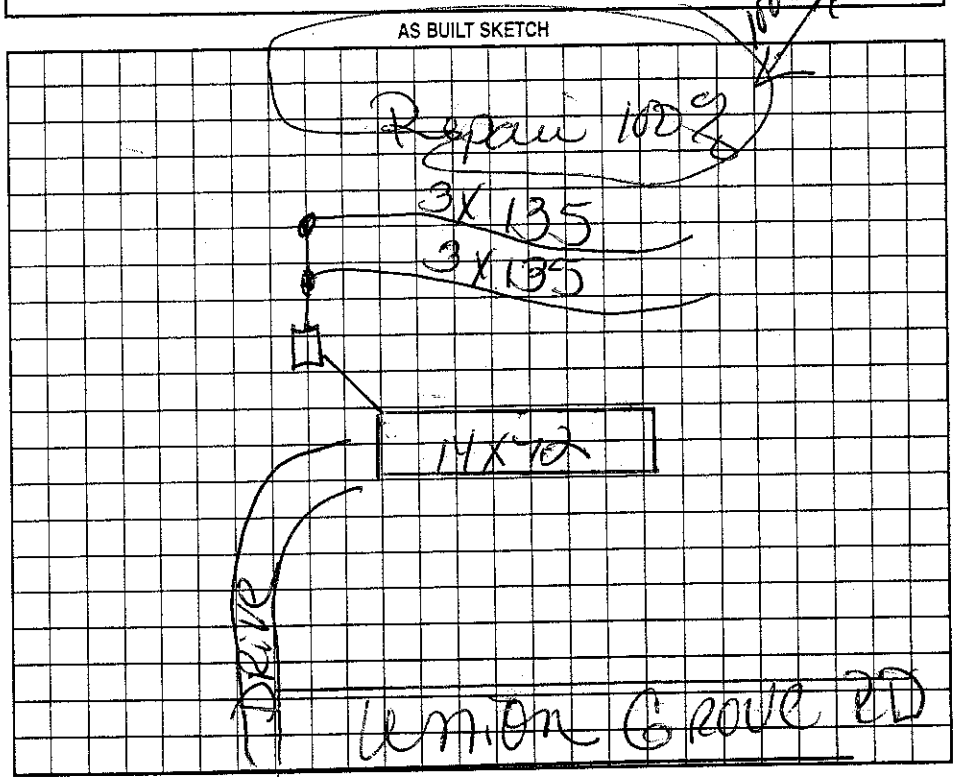

Permit can be suspended or revoked if any false information is supplied toward securing the permit/any unauthorized changes are made to the site/any unauthorized changes are made in the installation of the system. Improvement Permit with plat valid without expiration. Improvement Permit with site plan valid for sixty months. Authorization to Construct is valid for a period equal to that of Improvement Permit – not to exceed sixty months.

Signed: Tommy York date _____

Improvement Permit by: _____ date _____

Authorization to Construct by: _____ date _____

Installed by: _____

Operation Permit by: _____ date _____

Existing System Inspection by: Keely Cook date 1-26-09

HEALTH DEPT. COPY: WHITE OWNER COPY (FINAL): YELLOW OWNER COPY (INITIAL): PINK