IREDELL COUNTY HEALTH DEPARTMENT

STATESVILLE 704-878-5305 MOORESVILLE 704-664-5281

IMPROVEMENT PERMIT / AUTHORIZATION TO CONSTRUCT / OPERATION PERMIT / EXISTING SYSTEM INSPECTION

PERMIT# 088787 PIN# 4864 51 92360 DATE 5-5-00

OWNER OR CONTRACTOR CHUCK LIPPARD PHONE: Business Home 871-2435

ADDRESS 1933 GUY STREET STATESVILLE, NC 28677

LOCATION I-77 NORTH, TR NC901, TL EAGLE MILLS RD, TR OLD WESLEY ROAD, AT END ON LEFT

SUBDIVISION BLOCK / SECTION LOT LOT AREA 15.94 Acres SITE CLASS PS DESIGN FLOW 360 L.T.A.R. 0.30 GPD/FT²

Septic Tank: 1000 Gallons; STB 1012 Date 3-17-01
Pump Tank: Gallons; PT Date
Pump Make: Model Serial No.
Nitrification Field: No Fields 1 Square Feet 1200 Linear Feet 400
No Lines SIX Trench Width 36" Max Trench Bottom Depth 30" Gravel Depth 12"

☑ New System ☐ Repair System Type: I II III IV V VI
System Description: CONVENTIONAL, GRAVITY
Repair System Description: CONVENTIONAL, PUMP
Maintenance Agreement Required: ☐ Yes ☑ No
☐ Slab ☑ Crawl Space ☐ Basement w/plumbing ☐ Basement wo/plumbing


☑ House/Mod. Home No. Bedrooms 3
☐ Mobile Home No. Bathrooms 2½
☐ Business No. Employees
☐ Other

Water Supply: ☑ Individual ☐ Public ☐ Community WELL


Comments:/Conditions: KEEP WELL MINIMUM 100 FEET FROM SYSTEM

Comments /Conditions: ① SEPTIC TANK WITH MARKER INSTALLED USING "POLYLOK" FILTER
② SEPTIC TANK RELOCATED AS SHOWN WITH PRIOR HEALTH DEPARTMENT APPROVAL

INITIAL SITE SKETCH ~ SCALE: 1" = 50'

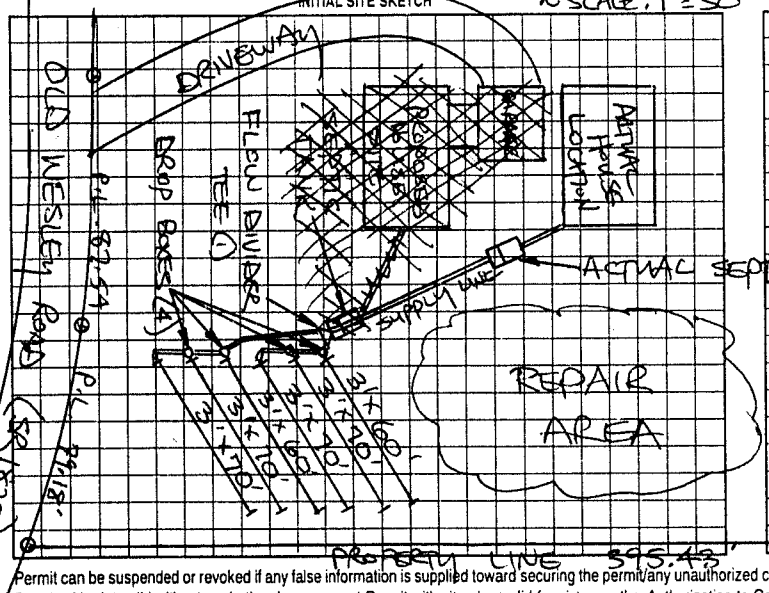

AS BUILT SKETCH

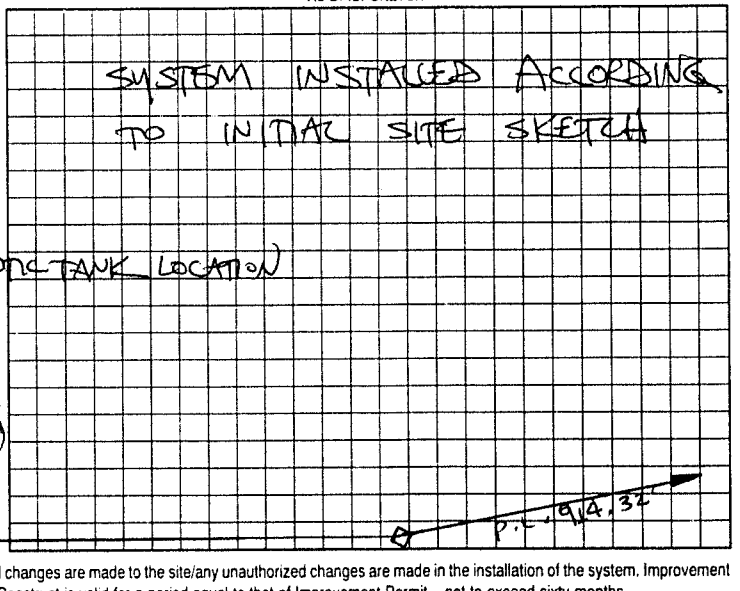

Permit can be suspended or revoked if any false information is supplied toward securing the permit/any unauthorized changes are made to the site/any unauthorized changes are made in the installation of the system. Improvement Permit with plat valid without expiration. Improvement Permit with site plan valid for sixty months. Authorization to Construct is valid for a period equal to that of Improvement Permit – not to exceed sixty months.

Signed: +Chuck W. Lippard date 5/5/2000 Installed by: AUSTIN & AUSTIN BUILDERS

Improvement Permit by: STEVE HEDRICK date 5-5-00 Operation Permit by: STEVE HEDRICK date 6-7-2001

Authorization to Construct by: STEVE HEDRICK date 5-5-00 Existing System Inspection by: date

HEALTH DEPT. COPY: WHITE OWNER COPY (FINAL): YELLOW OWNER COPY (INITIAL): PINK