IREDELL COUNTY HEALTH DEPARTMENT

STATESVILLE 704-878-5305 MOORESVILLE 704-664-5281

IMPROVEMENT PERMIT / AUTHORIZATION TO CONSTRUCT / OPERATION PERMIT / EXISTING SYSTEM INSPECTION

PERMIT# REPAIR PIN# 4864-92-7226 5512 DATE 2-11-05

OWNER OR CONTRACTOR RONALD A. BELL, JR PHONE: Business Home 704-539-4165

ADDRESS 736 BARNARD MILL ROAD, HAMPTONVILLE, NC 27020

LOCATION US 21 NORTH, TL BARNARD MILL ROAD, ON RIGHT AT #736

SUBDIVISION BLOCK / SECTION LOT LOT AREA 16.86 ACRES SITE CLASS. PS DESIGN FLOW 240 L.T.A.R. 0.30 GPD/FT²

Septic Tank: 1000 Gallons; STB 620 Date 10-27-04
Pump Tank: Gallons; PT Date
Pump Make: Model Serial No.
Nitrification Field: No Fields 1 Square Feet 810 Linear Feet 270
No Lines THREE Trench Width 36" Max Trench Bottom Depth 36" Gravel Depth 12"

☐ New System ☑ Repair System Type: I, II, III, IV, V, VI
System Description:
Repair System Description: CONVENTIONAL GRAVITY
Maintenance Agreement Required: ☐ Yes ☑ No

☐ House/Mod. Home No. Bedrooms 2
☐ Mobile Home No. Bathrooms
☐ Business No. Employees
☐ Other


☐ Slab ☑ Crawl Space ☐ Basement w/plumbing ☐ Basement wo/plumbing

Water Supply: ☑ Individual ☐ Public ☐ Community


Comments:/Conditions: INSTALL NEW SEPTIC TANK AS SHOWN, INSTALL NEW DRAW LINES ON CONTOUR AS FLAGGED.

Comments:/Conditions: SEPTIC TANK WITH RISERS INSTALLED USING "ZABEL" FILTER.

INITIAL SITE SKETCH

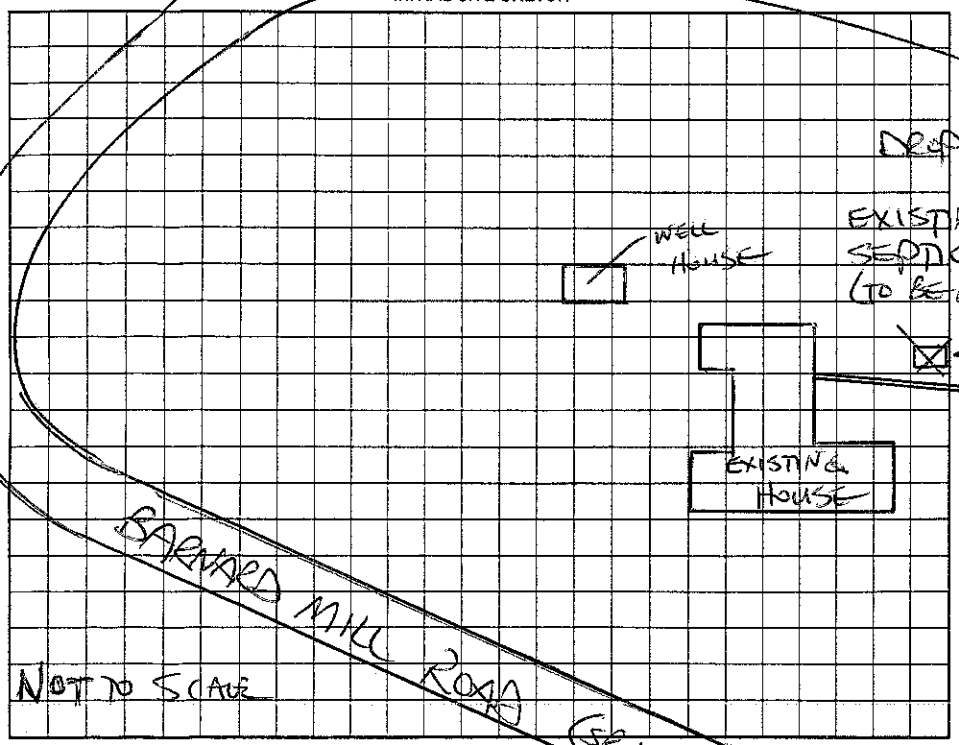

AS BUILT SKETCH

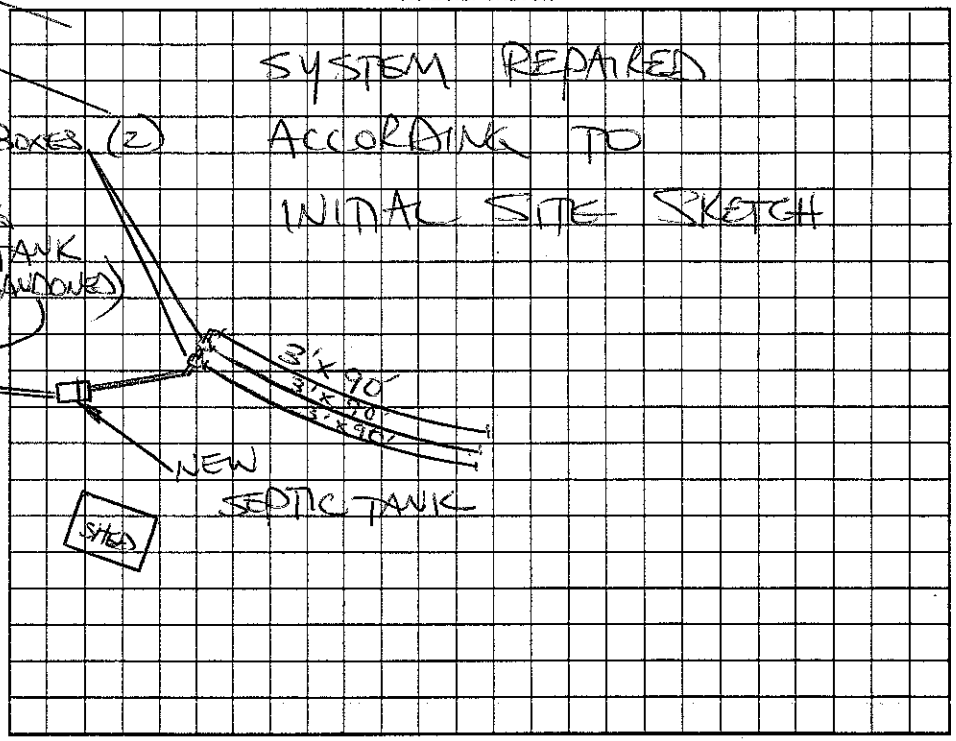

Permit can be suspended or revoked if any false information is supplied toward securing the permit/any unauthorized changes are made to the site/any unauthorized changes are made in the installation of the system. Improvement Permit with plat valid without expiration. Improvement Permit with site plan valid for sixty months. Authorization to Construct is valid for a period equal to that of Improvement Permit – not to exceed sixty months.

Signed: Ronald A Bell date 2-11-05 Installed by: Tommy Nixon

Improvement Permit by: STEVE HENDRICK date 2-11-05 Operation Permit by: Steve Hendrick date 2-16-05

Authorization to Construct by: STEVE HENDRICK date 2-11-05 Existing System Inspection by: date

HEALTH DEPT. COPY: WHITE OWNER COPY (FINAL): YELLOW OWNER COPY (INITIAL): PINK