IREDELL COUNTY HEALTH DEPARTMENT

STATESVILLE 704-878-5305 MOORESVILLE 704-664-5281

IMPROVEMENT PERMIT / AUTHORIZATION TO CONSTRUCT / OPERATION PERMIT / EXISTING SYSTEM INSPECTION

PERMIT# 074069 PIN# 4870 06 2990 DATE 6-22-98

OWNER OR CONTRACTOR TANYA STEVENSON PHONE: Business Home 546-7109

ADDRESS 356 TOMLIN ROAD, HARMONY, NC 28634

LOCATION US 21 N, TL TOMLIN ROAD, 1 ON RIGHT AT BOX # 356

SUBDIVISION BLOCK / SECTION LOT LOT AREA 0.524 ACRE SITE CLASS PS DESIGN FLOW 360 L.T.A.R. 0.35 GPD/FT²

Septic Tank: EXISTING Gallons; STB Date

Pump Tank: Gallons; PT Date

Pump Make: Model Serial No.

Nitrification Field: No Fields 1 Square Feet EQ to 345 Linear Feet 90+

No Lines 1 Trench Width 36" Max Trench Bottom Depth 36" Gravel Depth SAND 6"

☑ New System ☐ Repair System Type: I, II, III, IV, V, VI

System Description: CHAMBERED GRAVITY

Repair System Description: PIPES GRAVITY

Maintenance Agreement Required: ☐ Yes ☑ No

☐ House/Mod. Home ☑ Mobile Home ☐ Business ☐ Other

No. Bedrooms 3 No. Bathrooms 2 No. Employees


Water Supply: ☐ Individual ☐ Public ☐ Community

☐ Slab ☑ Crawl Space ☐ Basement w/plumbing ☐ Basement wo/plumbing


Comments:/Conditions: INSTALL NEW DROP BOX FOR SERIAL DISTRIBUTION INTO NEW LINE ON CONTOUR CONSISTING OF 15 (FIFTEEN) CHAMBERS

Comments:/Conditions:

INITIAL SITE SKETCH SCALE: 1" = 40'

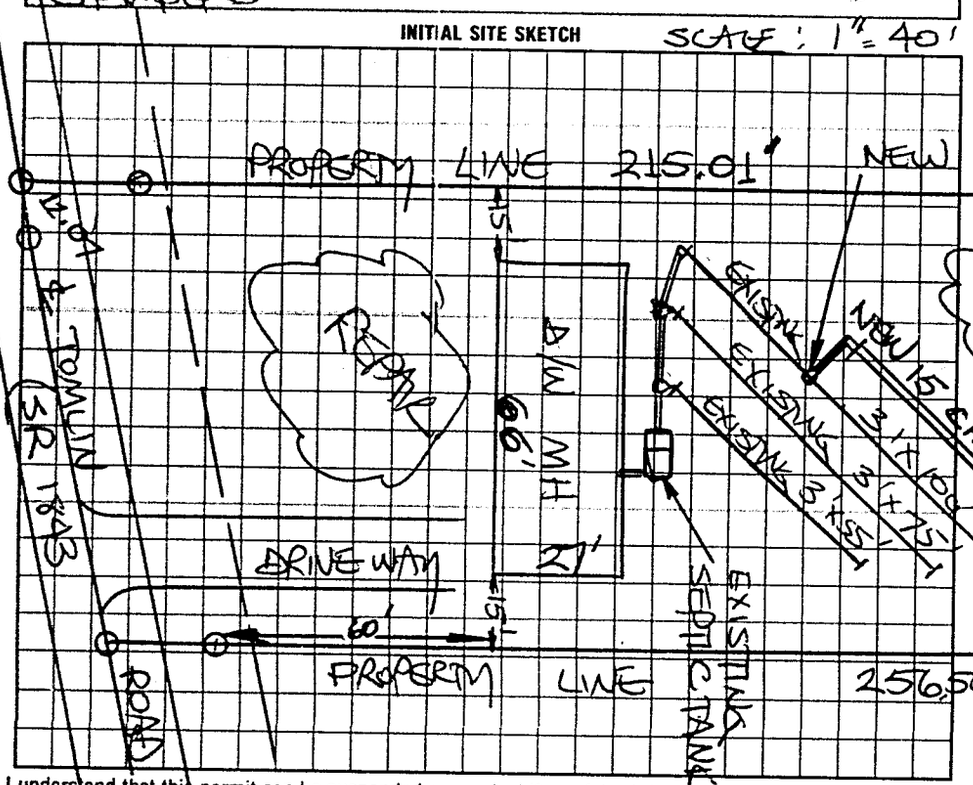

AS BUILT SKETCH

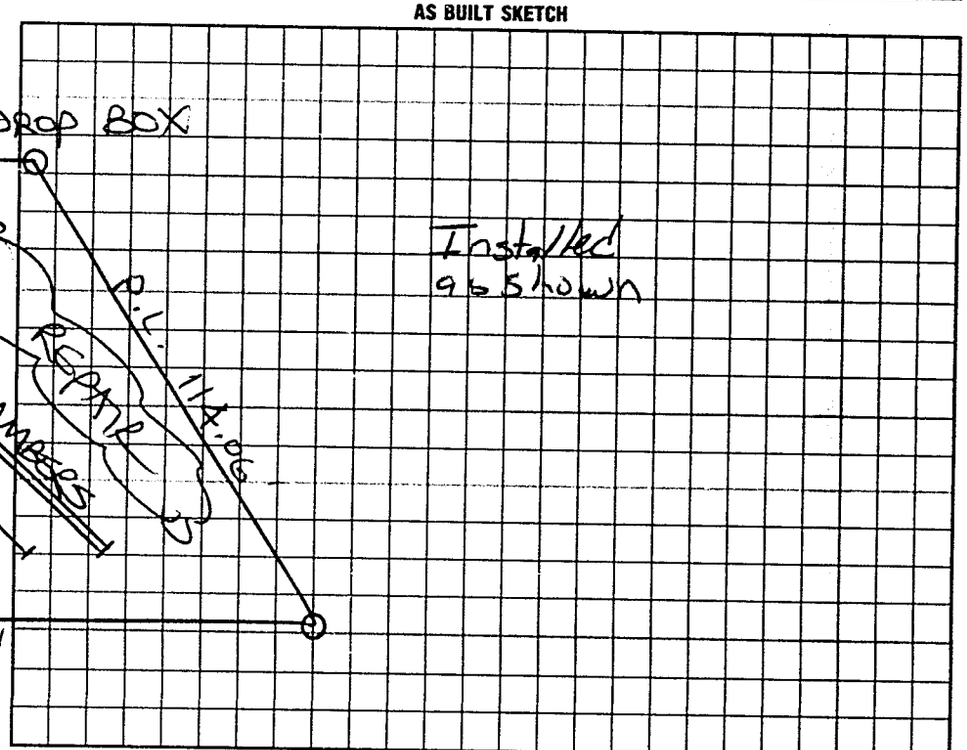

I understand that this permit can be suspended or revoked if any false information is supplied toward securing the permit/any unauthorized changes are made to the site/any unauthorized changes are made in the installation of the system. Improvement Permit with plat valid without expiration. Improvement Permit with site plan valid for sixty months. Authorization to Construct is valid for a period equal to that of Improvement Permit – not to exceed sixty months.

Signed: Tanya Stevenson date 6-22-98 Installed by: Cody

Improvement Permit by: STEVE HEDRICK date 6-22-98 Operation Permit by: [illegible] RS date 7-7-98

Authorization to Construct by: STEVE HEDRICK date 6-22-98 Existing System Inspection by: date

HEALTH DEPT COPY WHITE INSPECTION COPY (FINAL) GREEN OWNER COPY (FINAL) YELLOW INSPECTION COPY (INITIAL) PINK OWNER COPY (INITIAL) GOLD