IREDELL COUNTY HEALTH DEPARTMENT

STATESVILLE 704-878-5305 MOORESVILLE 704-664-5281

IMPROVEMENT PERMIT / AUTHORIZATION TO CONSTRUCT / OPERATION PERMIT / EXISTING SYSTEM INSPECTION

PERMIT# REPAIR PIN# 4870-10-5963 DATE 12-15-03

OWNER OR CONTRACTOR Larry Morris PHONE: Business _____ Home 704-546-2137

ADDRESS _____

LOCATION Hwy 21 N @ Gallaher Rd Property at end of cul-de-sac on left

SUBDIVISION _____ BLOCK / SECTION _____ LOT _____ LOT AREA _____ SITE CLASS. RS DESIGN FLOW 36 L.T.A.R. EXIST

Septic Tank: EXIST Gallons; STB _____ Date _____

Pump Tank: N/A Gallons; PT _____ Date _____

Pump Make: N/A Model _____ Serial No. _____

Nitrification Field: No Fields EXIST Square Feet _____ Linear Feet _____

No Lines _____ Trench Width _____ Max Trench Bottom Depth _____ Gravel Depth _____

☐ New System ☑ Repair System Type: I (II) III, IV, V, VI

System Description: _____

Repair System Description: Conventional gravity

Maintenance Agreement Required: ☐ Yes ☑ No

☑ House/Mod. Home No. Bedrooms 3

☐ Mobile Home No. Bathrooms 1

☐ Business No. Employees _____

☐ Other _____


☐ Slab ☑ Crawl Space ☐ Basement w/plumbing ☐ Basement wo/plumbing

Water Supply: ☐ Individual ☑ Public ☑ Community

Comments:/Conditions: ① Replace supply line w/ new 3" sch 40 pipe ② Install new d-box w/ speed levelers ③ Install filter in tank w/ PVC outlet * ④ This permit serves as a Notice of Violation and must be repaired by 1-15-04

Comments:/Conditions: Tuff-tite filter
* Used drop box instead of d-box
* Installed as shown in Authorization Permit

INITIAL SITE SKETCH 1"=50'

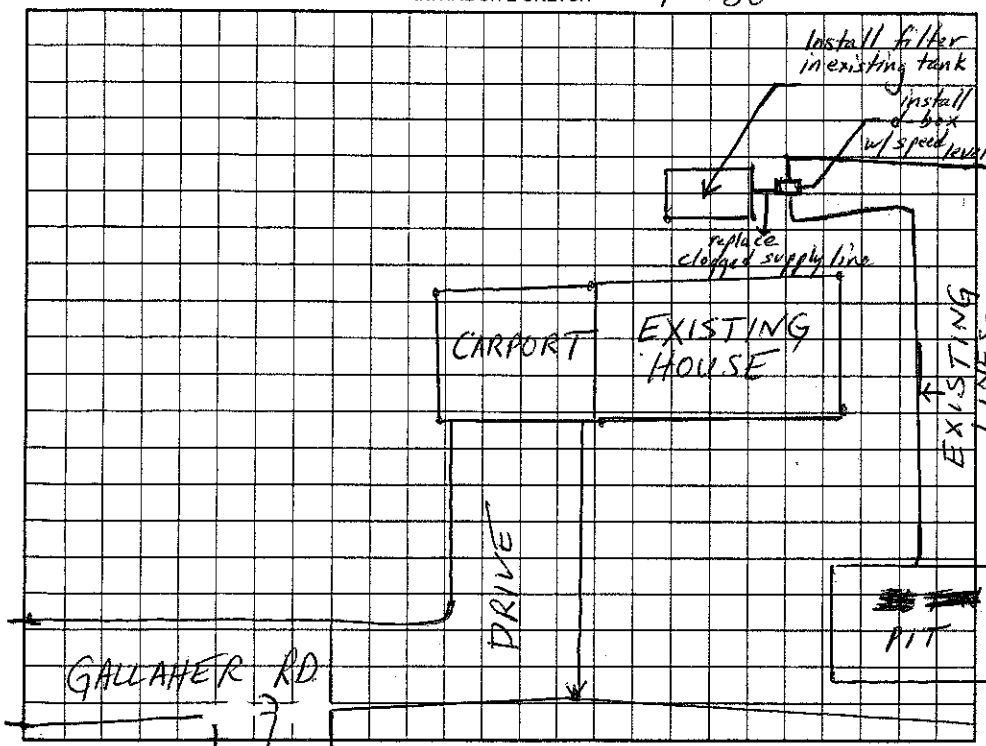

Property Line

AS BUILT SKETCH

Permit can be suspended or revoked if any false information is supplied toward securing the permit/any unauthorized changes are made to the site/any unauthorized changes are made in the installation of the system. Improvement Permit with plat valid without expiration. Improvement Permit with site plan valid for sixty months. Authorization to Construct is valid for a period equal to that of Improvement Permit – not to exceed sixty months.

Signed: Larry Morris date 16 Dec 2003 Installed by: Sammy Reavis

Improvement Permit by: Christopher M. Sherrill, RS date 12-15-03 Operation Permit by: Christopher M. Sherrill, RS date 1/2/04

Authorization to Construct by: Christopher M. Sherrill, RS date 12-16-03 Existing System Inspection by: _____ date _____

HEALTH DEPT. COPY: WHITE OWNER COPY (FINAL): YELLOW OWNER COPY (INITIAL): PINK