IREDELL COUNTY HEALTH DEPARTMENT

THIS PERMIT VOIDS PREVIOUS ISSUED 10-22-98

STATESVILLE 704-878-5305 MOORESVILLE 704-664-5281

IMPROVEMENT PERMIT / AUTHORIZATION TO CONSTRUCT / OPERATION PERMIT / EXISTING SYSTEM INSPECTION

PERMIT# 077048 PIN# 4870 10 6659 DATE 3-2-99

OWNER OR CONTRACTOR GERETHA WASHINGTON PHONE: Business Home 546-5479

ADDRESS 6806 NASHVILLE ROAD, LANHAM MD, 20706

LOCATION US 21 NORTH, TL SALUTER ROAD, 7TH DRIVEWAY ON LEFT

SUBDIVISION BLOCK / SECTION LOT LOT AREA 1.500 ACRES SITE CLASS P5 DESIGN FLOW 360 L.T.A.R. 0.30 GPD/FT2

Septic Tank: 1000 Gallons; STB 1012 Date 12-24-98

Pump Tank: Gallons; PT Date

Pump Make: Model Serial No.

Nitrification Field: No Fields 1 Square Feet 1200 Linear Feet 400

No Lines FOUR Trench Width 36" Max Trench Bottom Depth 36" Gravel Depth 12"

✓ New System Repair System Type: I II III IV V VI

System Description: CONVENTIONAL GRAVITY

Repair System Description: CONV. GRAVITY

Maintenance Agreement Required Yes ✓ No

✓ House/Mod. Home No. Bedrooms 3

Mobile Home No. Bathrooms 2

Business No. Employees

Other


Slab ✓ Crawl Space Basement w/plumbing Basement wo/plumbing

Water Supply: ☐ Individual ✓ Public ☐ Community


Comments/Conditions: THIS PERMIT VOIDS PREVIOUS ISSUED 10-22-98

Comments Conditions

INITIAL SITE SKETCH

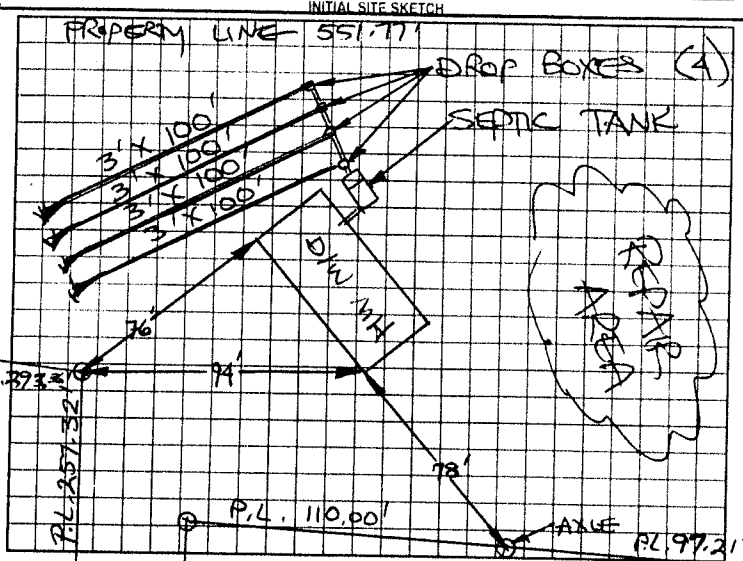

AS BUILT SKETCH

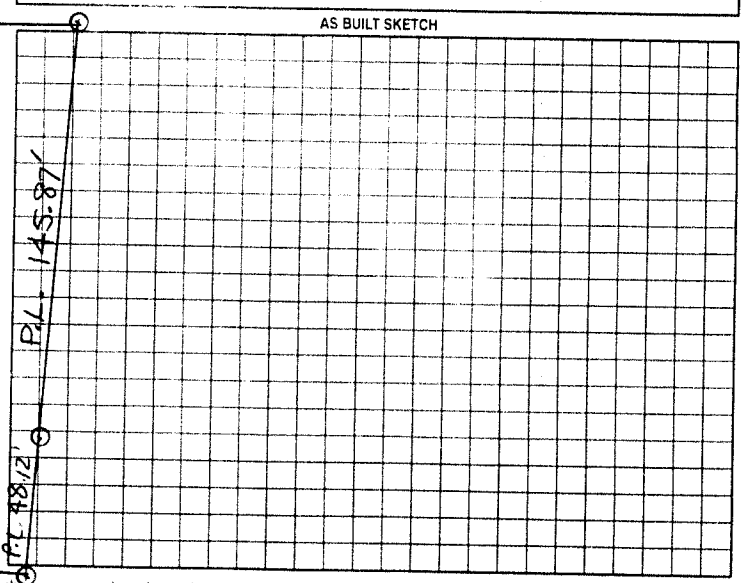

Permit can be suspended or revoked if any false information is supplied toward securing the permit/any unauthorized changes are made to the site/any unauthorized changes are made in the installation of the system. Improvement Permit with plat valid without expiration. Improvement Permit with site plan valid for sixty months. Authorization to Construct is valid for a period equal to that of Improvement Permit – not to exceed sixty months.

Signed: Elaine M. Steele date 3-2-99

Improvement Permit by: STEVE HEDRICK date 3-2-99

Authorization to Construct by: STEVE HEDRICK date 3-2-99

Installed by: A-1 Backhoe

Operation Permit by: [signature] date 3-3-99

Existing System Inspection by: date

HEALTH DEPT COPY WHITE OWNER COPY (FINAL) YELLOW OWNER COPY (INITIAL) PINK