IREDELL COUNTY HEALTH DEPARTMENT

STATESVILLE 704-878-5305 MOORESVILLE 704-664-5281

IMPROVEMENT PERMIT / CERTIFICATE OF COMPLETION / OPERATION PERMIT / EXISTING SYSTEM INSPECTION

PROPERTY DESCRIPTION NO. 066916 DATE 6-10-97 TAX MAP NO. 4870 1 4531 Watershed: ☐ Yes ☑ No

OWNER OR CONTRACTOR ROBERT L. KIRBY PHONE: Business Home 546-5187

ADDRESS P.O. BOX 401 HARMONY NC 28634

LOCATION US 21 N, TL GALLIHER ROAD, 1ST STRAIGHT AHEAD AT CUL-DE-SAC,

SUBDIVISION BLOCK / SECTION LOT LOT AREA 3.0 ACRES SITE CLASS. PS DESIGN FLOW 360 L.T.A.R. 0.40 GPD/FT²

Septic Tank: 1000 Gallons; STB 760 Date 5-23-97

Pump Tank: Gallons; PT Date

Pump Make: Model Serial No.

Nitrification Field: No Fields 1 Square Feet 900 Linear Feet 300

No Lines FIVE Trench Width 36" Max Trench Bottom Depth 36" Gravel Depth 12"

☑ New System ☐ Repair System Type: I II III IV V VI

System Description: CONVENTIONAL GRAVITY

Repair System Description: CONV. GRAVITY

Maintenance Agreement Required: ☐ Yes ☑ No

☑ House/Mod. Home No. Bedrooms 3

☑ Mobile Home No. Bathrooms 2

☐ Business No. Employees

☐ Other


☐ Slab ☑ Crawl Space ☐ Basement w/plumbing ☐ Basement wo/plumbing

Water Supply: ☐ Individual ☐ Community ☑ Public


Comments:

Comments:

INITIAL SITE SKETCH SCALE: 1"=40'

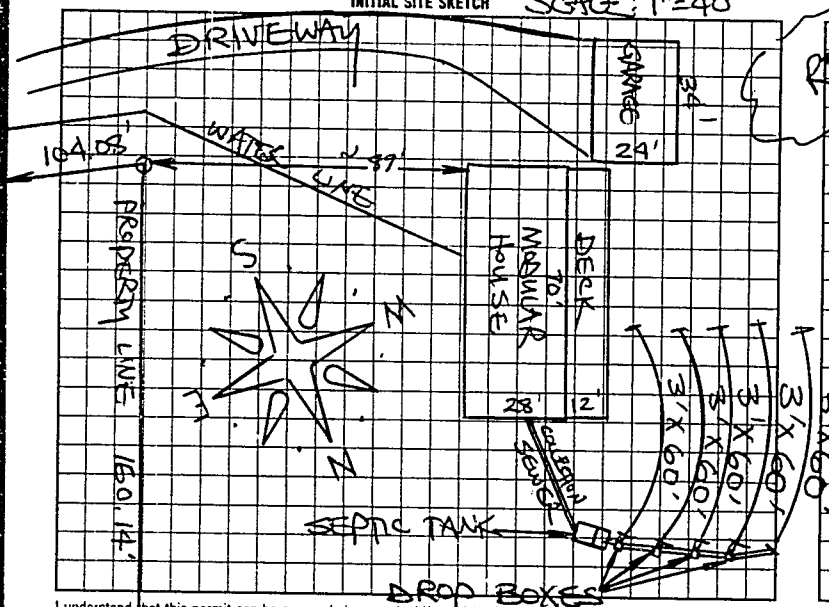

AS BUILT SKETCH

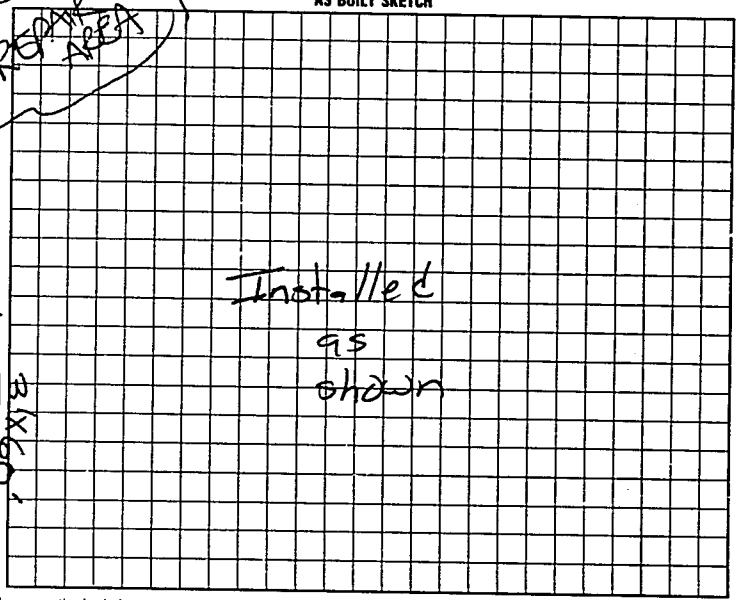

I understand that this permit can be suspended or revoked if any false information is supplied toward securing the permit/any unauthorized changes are made to the site/any unauthorized changes are made in the installation of the system. Improvement Permit is valid for 60 months from date of issuance. AUTHORIZATION TO CONSTRUCT IS VALID FOR 60 MONTHS FROM DATE OF ISSUANCE

Signed

Improvement Permit by: STEVE HEDRICK date 6-10-97

AUTH. TO CONST.

Existing System Inspection by: STEVE HEDRICK date 6-10-97

Installed by: Grimes Septic Service

~~Certificate of Completion by:~~ date

Operation Permit by Mary C Oates date 8-13-97

52.21' 325.01'

INSPECTION COPY (FINAL) GREEN OWNER COPY (FINAL) YELLOW INSPECTION COPY (INITIAL) PINK OWNER COPY (INITIAL) GOLD

00152 3