ICHD - ENVIRONMENTAL HEALTH DIVISION

Statesville Office (704) 878-5305 | Mooresville Office (704) 660-3625 (MW) | PERMIT # **AP** 2022-4267

SEPTIC: IMPROVEMENT PERMIT / AUTHORIZATION TO CONSTRUCT / OPERATION PERMIT / EXISTING SYSTEM

PIN # 4870 -- 14 -- 0794

APPLICANT/OWNER: Thelma Gaither | APPLICANT ADDRESS: 249 Hickory Grove Rd, Harmony

SITE ADDRESS: 249 Hickory Grove Rd, Harmony 28634 | PHONE: 704-546-7362 | ALT. PHONE: -

SITE DIRECTIONS: 21 N - Tomlin Rd - Hickory Grove Rd | SAP CONTROLLED: ☐ YES ☐ NO

SUBDIVISION: - | SECTION: - | LOT #: - | LOT AREA: 0.5 acres | DESIGN FLOW: EX | L.T.A.R.: EX

Septic Tank	1000 (gal)	STB	1012	Date	10-5-22	☐ New System ☒ Repair ☐ Expansion	System Type: I (II) III IV V VI
Pump Tank	(gal)	PT		Date		System Description: -	
Pump Make		Model		Serial #		Repair System Description:	Tank replacement
# Nitrification Fields	EX	# Lines	EX	Linear Ft	EX	Maintenance Agreement Required:	☐ YES ☒ NO
Trench Width	EX	Trench Bottom Depth(Low side)	EX	Gravel Depth	EX	☒ GRAVITY	☐ PRESSURE


☒ Residence ☐ Business ☐ Other ☐ Slab ☐ Basement w/plumbing

No. Bedrooms: EX | No. Persons: EX | No. Employees: | ☒ Crawl Space | ☐ Basement w/o plumbing

Water Supply: ☐ Private ☒ Public ☐ Community

Comments / Conditions: Pump, crush, & fill old septic tank. Replace distribution if necessary.

INITIAL SITE SKETCH

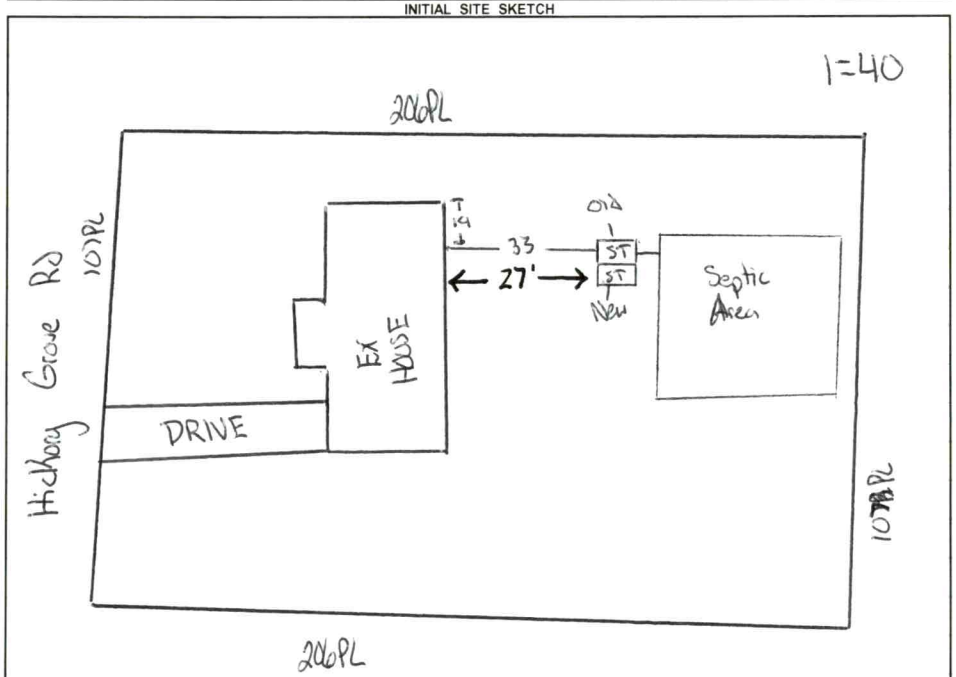

AS BUILT SKETCH

FOR SEPTIC FINAL INSPECTION CALL: 704-664-3703 between 8am-9am the day the inspection is needed. Be sure to speak with an inspector to confirm your time.

Installed as drawn

Permit can be suspended or revoked if any false information is supplied toward securing the permit / any unauthorized changes are made to the site / any unauthorized changes are made in the installation of the system. **CONTACT A LOCATOR SERVICE PRIOR TO ANY EXCAVATION**

☐ **IMPROVEMENT PERMIT** ***with plat*** *valid without expiration.* ☒ **IMPROVEMENT PERMIT** ***with site plan*** *valid for 60 mos.* ☒ **AUTHORIZATION TO CONSTRUCT** *valid for period equal to IMPROVEMENT PERMIT--not to exceed 60 mo.*

Owner / Applicant Signature: _____ Date: _____ Installed by: Powell Septic

IMPROVEMENT PERMIT by: Cary Welch Date: 9/26/22 OPERATION PERMIT by: Sydney Holland Date: 12-19-22

AUTHORIZATION TO CONSTRUCT by: Cary Welch Date: 9/26/22 Existing System Inspected by: _____ Date: _____

FOR SEPTIC FINAL INSPECTION: CALL 704-664-3703 between 8am-9am the day the inspection is needed.

Item	Date	Initials
Drain Lines Checked		
Tanks Checked		
Pressure Manifold or Valve Box Checked		
Pressure Head Set		
Electrical Checked		
Floats Set		
Alarm Checked		
Maintenance Contract Needed? Y / N		
Comments:		

Repairs Only	
	State Code
Failing System Code	
Type of Distribution	G or P
Type of Failure/Malfunction	
Primary Cause of Failure/Malfunction	
Age of System? _____	
Initial or Repair? _____	