IREDELL COUNTY HEALTH DEPARTMENT

STATESVILLE 704-878-5305 MOORESVILLE 704-664-5281

IMPROVEMENT PERMIT / AUTHORIZATION TO CONSTRUCT / OPERATION PERMIT / EXISTING SYSTEM INSPECTION

PERMIT # 153639 PIN # 4870-16-4979 DATE 12-4-08

OWNER or APPLICANT Sam Tomlin PHONE: Business 704 546 2635 Home:

OWNER or APPLICANT ADDRESS 304 Tomlin Drive

LOCATION / DIRECTIONS 304 Tomlin Drive

SUBDIVISION n/a BLOCK / SECTION LOT # LOT AREA 9.68 DESIGN FLOW 240 L.T.A.R. Ex.

Septic Tank Ex. Gallons: STB Ex. Date

Pump Tank Gallons: P T Date

Pump Make Model Serial #

Nitrification Field No Fields 1 No Lines 2 Linear Feet 250

Trench Width Ex Max. Trench Bottom Depth Ex. Gravel Depth 10"

☐ New System ☐ Repair ☐ Expansion System Type I II III IV V VI

System Description: Existing System

Repair System Description:

Maintenance Agreement Required ☐ YES ☐ NO

☒ GRAVITY ☐ PRESSURE

☒ Residence No. Bedrooms 2

☐ Business No. Persons

☐ Other No. Employees

☐ Slab ☒ Crawl Space

☐ Basement w/plumbing ☐ Basement w/o plumbing


Water Supply: ☒ Private ☐ Public ☐ Community

Comments / Conditions

Comments / Conditions

INITIAL SITE SKETCH

AS BUILT SKETCH

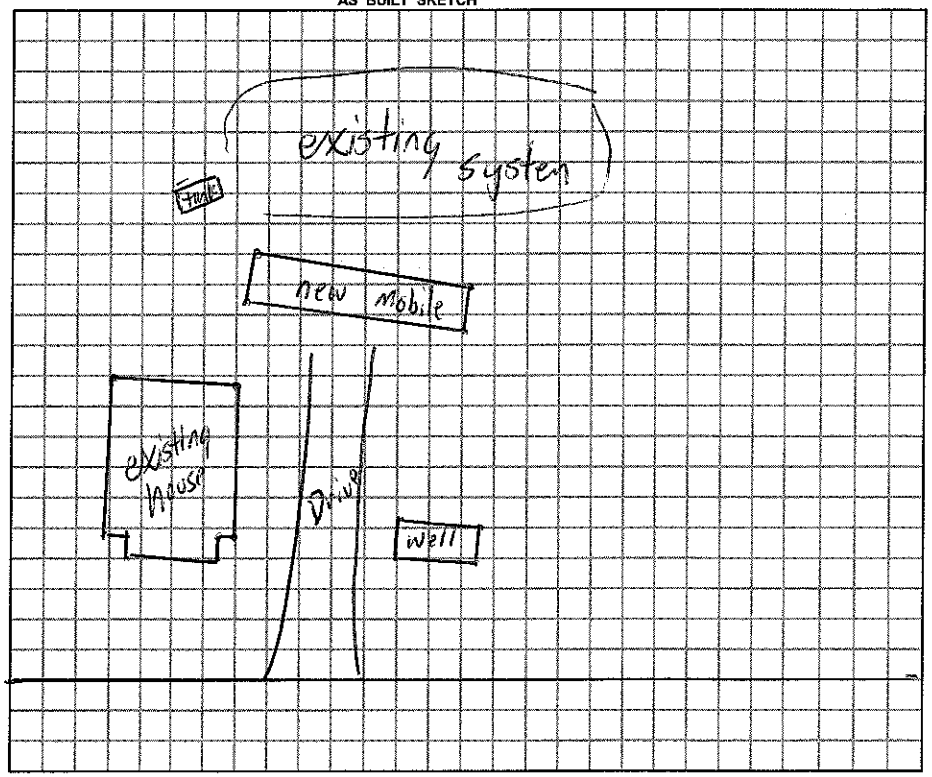

Permit can be suspended or revoked if any false information is supplied toward securing the permit / any unauthorized changes are made to the site / any unauthorized changes are made in the installation of the system.

☐ *IMPROVEMENT PERMIT w / plat valid without expiration.* ☐ *IMPROVEMENT PERMIT w / site plan valid for 60 mos.* ☐ *AUTHORIZATION TO CONSTRUCT valid for period equal to IMPROVEMENT PERMIT-not to exceed 60 mo.*

Owner / Applicant Signature: Sam Tomlin Date 12-16 08

Installed by:

Improvement Permit by: Date

Operation Permit by: Date:

Authorization to Construct by: Date

Existing System Inspected by: Date: 12-4-08

YOU SHOULD CONTACT A LOCATOR SERVICE PRIOR TO ANY EXCAVATION.

WHITE COPY Environmental Health YELLOW COPY (Final) Owner / Applicant PINK COPY (Initial) Owner / Applicant