IREDELL COUNTY HEALTH DEPARTMENT

STATESVILLE 704-878-5305 MOORESVILLE 704-664-5281

IMPROVEMENT PERMIT / AUTHORIZATION TO CONSTRUCT / OPERATION PERMIT / EXISTING SYSTEM INSPECTION

PERMIT# 91304 PIN# 4870 16 7382 DATE 8-15-00

OWNER OR CONTRACTOR Adrian Elledge PHONE: Business Home 540 628 8051

ADDRESS 20005 Hortenstine Pl Abingdon VA.

LOCATION US 21 N TL Tomlin Rd at Harmony .7mi left across from 268

SUBDIVISION BLOCK / SECTION LOT LOT AREA 13.3 acres SITE CLASS PS DESIGN FLOW 240 L.T.A.R. .33

Septic Tank: 1000 Gallons; STB 1012 Date 6-21-00
Pump Tank: Gallons; PT Date
Pump Make: Model Serial No.
Nitrification Field: No Fields 1 Square Feet 720 Linear Feet 240
No Lines 3 Trench Width 24" Max Trench Bottom Depth 36" Gravel Depth 12"

☒ New System ☐ Repair System Type: I. II. III. IV. V. VI
System Description: Conv. Gravity
Repair System Description:
Maintenance Agreement Required: ☐ Yes ☒ No

☐ House/Mod. Home No. Bedrooms 2
☒ Mobile Home No. Bathrooms 1
☐ Business No. Employees
☐ Other


☐ Slab ☒ Crawl Space ☐ Basement w/plumbing ☐ Basement wo/plumbing

Water Supply: ☐ Individual ☒ Public ☐ Community


Comments/Conditions:

Comments/Conditions: SEPTIC TANK W/ MARKER INSTALLED USING "POLYLOK" FITTER

INITIAL SITE SKETCH

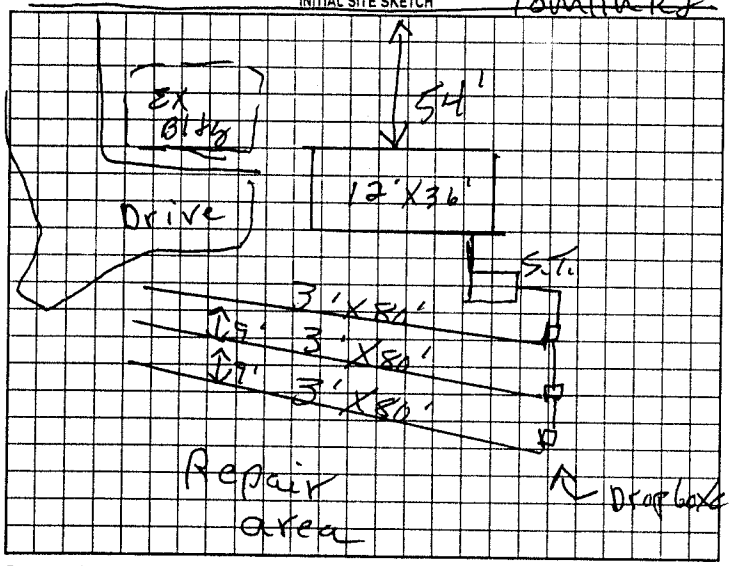

AS BUILT SKETCH

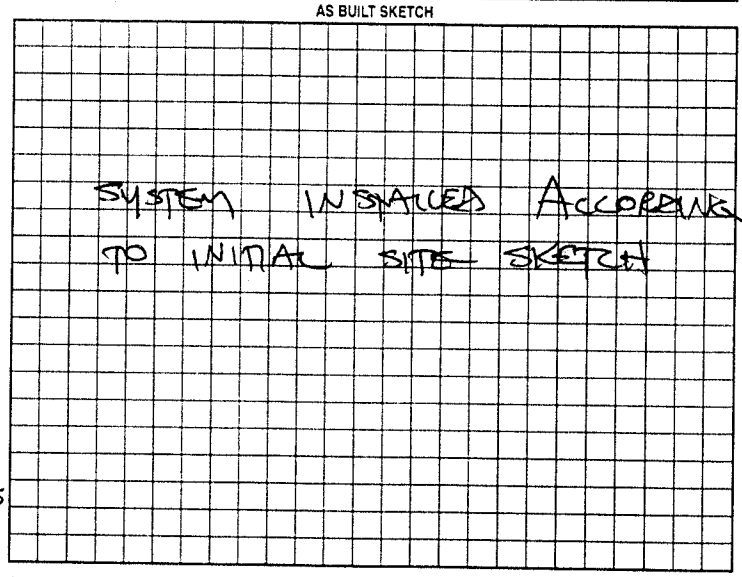

Permit can be suspended or revoked if any false information is supplied toward securing the permit/any unauthorized changes are made to the site/any unauthorized changes are made in the installation of the system. Improvement Permit with plat valid without expiration. Improvement Permit with site plan valid for sixty months. Authorization to Construct is valid for a period equal to that of Improvement Permit – not to exceed sixty months.

Signed: X Adrian Elledge date Installed by: Tommy Frye

Improvement Permit by: T. C. Moore date 8-15-00 Operation Permit by: Steve Herrick date 8-30-00

Authorization to Construct by: T. C. Moore date 8-15-00 Existing System Inspection by: date

HEALTH DEPT COPY WHITE OWNER COPY (FINAL) YELLOW OWNER COPY (INITIAL) PINK