IREDELL COUNTY HEALTH DEPARTMENT

Statesville Phone TR 3-7271 Mooresville Phone NO 3-1271

PERMIT TO INSTALL SEPTIC TANK

Permit Date 3-14 19 66

Permit NO. _____

Owner Gotch Feed Builder Address Harmony, N.C.

Installed By Sammy Rogers Address Harmony, N.C.

Location of Property Hwy 21 N. L. 1883 Toward 6/IN L


1934 ¼ L dirt Rd. Last house on left

Tank		Capacity		Length of Lines		Fixtures	
Block	( )	1000	( )	225'	( )	No. of Baths	( )
Precast	( )	1250	( )	250'	( )	Dishwasher	( )
		1500	( )	Other _____		Garbage Grdr.	( )
		Other _____				Other _____	

NOTIFY HEALTH DEPARTMENT AT LEAST EIGHT HOURS BEFORE TANK IS TO BE INSPECTED.

Final Inspection 3-14 19 66 Approved (✓) Disapproved ( )

Remarks _____

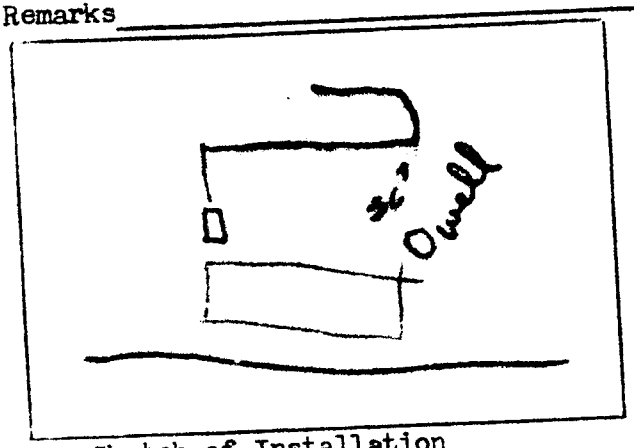

Sketch of Installation

Sanitarian