IREDELL COUNTY HEALTH DEPARTMENT

STATESVILLE 704-878-5305 MOORESVILLE 704-664-5281

IMPROVEMENT PERMIT / AUTHORIZATION TO CONSTRUCT / OPERATION PERMIT / EXISTING SYSTEM INSPECTION

PERMIT# 076621 PIN# 4870 24 2109 (PT) DATE 10-1-98

OWNER OR CONTRACTOR MICHAEL T. STANLEY PHONE: Business Home 539-4361

ADDRESS 219 JERICHO ROAD HARMONY NC 28634

LOCATION US 21 N, TL TOMLIN ROAD, TL HICKORY GROVE, TL BUCKHEAD, ON RIGHT AT BOX # 178

SUBDIVISION BLOCK / SECTION LOT LOT AREA 110'x297' SITE CLASS. PS DESIGN FLOW 360 L.T.A.R. 0.30 GPD/FT²

Septic Tank: 1000 Gallons; STB 1012 Date 8-7-98
Pump Tank: Gallons; PT Date
Pump Make: Model Serial No.
Nitrification Field: No Fields 1 Square Feet 1200 Linear Feet 400
No Lines THREE Trench Width 36" Max Trench Bottom Depth 24"

☑ New System ☐ Repair System Type: I, II, III, IV, V, VI
System Description: CONVENTIONAL GRAVITY
Repair System Description: 25% REDUCTION PUMP
Maintenance Agreement Required: ☐ Yes ☑ No
Gravel Depth 12" ☐ Slab ☑ Crawl Space ☐ Basement w/plumbing ☐ Basement wo/plumbing


☐ House/Mod. Home ☑ Mobile Home ☐ Business ☐ Other
No. Bedrooms 3 No. Bathrooms 2 No. Employees

Water Supply: ☐ Individual ☑ Public ☐ Community


Comments:/Conditions: INSTALL SUBSURFACE INTERCEPT DRAINAGE DITCH AS SHOWN BEGINNING 36" DEEP OUT TO DAYLIGHT, TRENCH BOTTOM TO BE INSPECTED PRIOR TO PLACING PIPE & STONE!

Comments:/Conditions: SEPTIC TANK & DRAINFIELD CHECKED OK ON 10-13-98
SUBSURFACE INTERCEPT DRAINAGE DITCH REMAINS TO BE INSTALLED CORRECTLY

INITIAL SITE SKETCH SCALE: 1"=50'

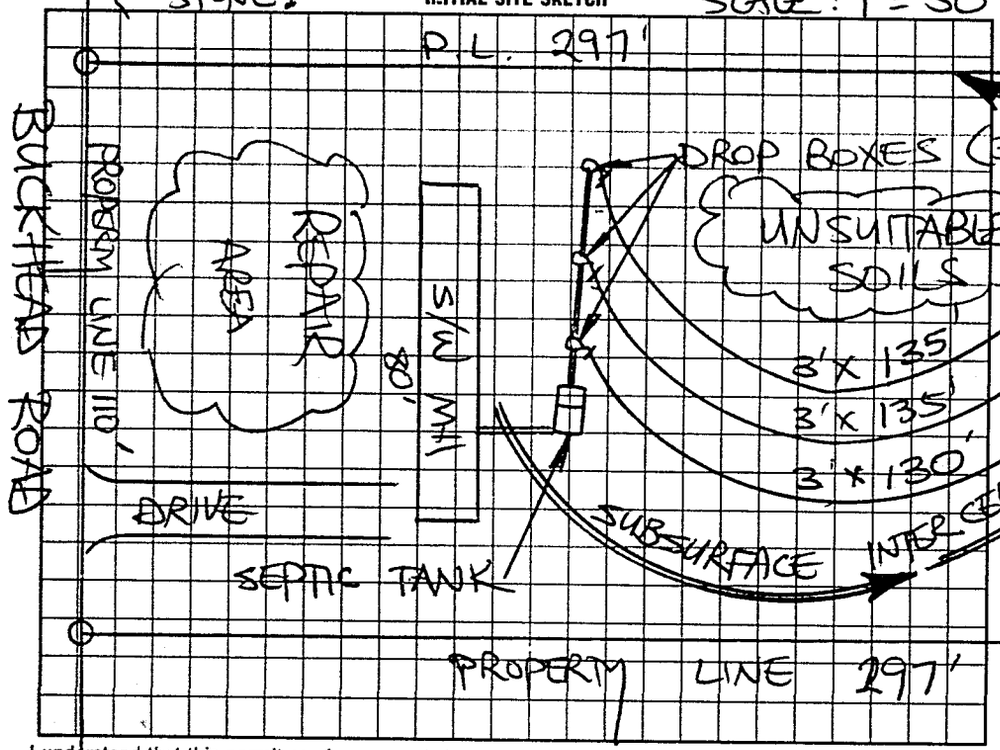

AS BUILT SKETCH

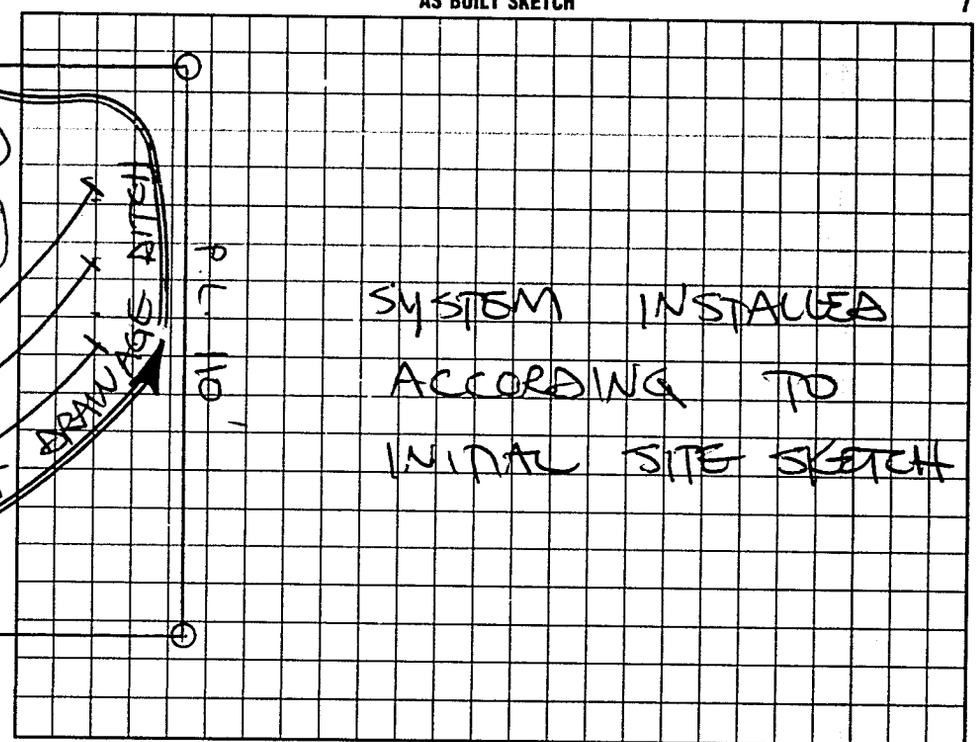

I understand that this permit can be suspended or revoked if any false information is supplied toward securing the permit/any unauthorized changes are made to the site/any unauthorized changes are made in the installation of the system. Improvement Permit with plat valid without expiration. Improvement Permit with site plan valid for sixty months. Authorization to Construct is valid for a period equal to that of Improvement Permit – not to exceed sixty months.

Signed: Mike Stanley date 10-1-98

Improvement Permit by: STEVE HEDRICK date 10-1-98

Authorization to Construct by: STEVE HEDRICK date 10-1-98

Installed by: UNION GROVE SEPTIC (JEFF HURLBUT)

Operation Permit by: STEVE HEDRICK date 10-16-98

Existing System Inspection by: date

HEALTH DEPT. COPY: WHITE INSPECTION COPY (FINAL): GREEN OWNER COPY (FINAL): YELLOW INSPECTION COPY (INITIAL): PINK OWNER COPY (INITIAL): GOLD

076621