IREDELL COUNTY HEALTH DEPARTMENT

Statesville Phone TR 3-7271 Mooresville Phone NO 3-1271

PERMIT TO INSTALL SEPTIC TANK

Permit NO. _____ Permit Date 3-22 1966

Owner Goforth Lood Builder Address Harmony NC

Installed By Sonny Reavis Address Harmony NC


Location of Property Hwy 21 N 2 1883 Toward Olin 2 1935 1/10 mile 2 dirt Rd 1st house left.

Tank		Capacity		Length of Lines		Fixtures	
Block	( )	1000	(L)	225'	( )	No. of Baths	( )
Precast	( )	1250	( )	250'	( )	Dishwasher	( )
		1500	( )	Other _____		Garbage Grdr.	( )
		Other _____				Other _____	

NOTIFY HEALTH DEPARTMENT AT LEAST EIGHT HOURS BEFORE TANK IS TO BE INSPECTED.

Final Inspection 3-22 1966 Approved ( ) Disapproved ( )

Remarks _____

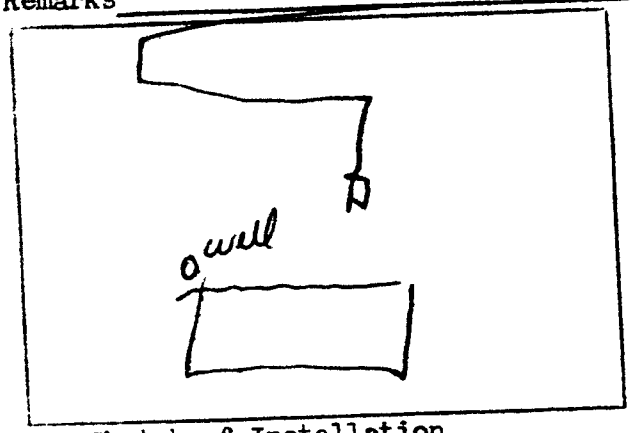

Sketch of Installation

Andrew G. Hatchuin R.S.

Sanitarian