IREDELL COUNTY HEALTH DEPARTMENT

STATESVILLE 704-878-5305 MOORESVILLE 704-664-5281

IMPROVEMENT PERMIT / AUTHORIZATION TO CONSTRUCT / OPERATION PERMIT / EXISTING SYSTEM INSPECTION

PERMIT# 08116 PIN# 4870 24 5698 DATE 5-18-99

OWNER OR CONTRACTOR THOMAS TURNER PHONE: Business Home 528-6063

ADDRESS 226 VALLEY BROOK LANE, TROUTMAN, NC 28166

LOCATION US 21 N, TL TOMLIN RD, TL HICKORY GROVE RD, TL BUCKHEAD RD, ON LEFT AT DEAR MARLON

SUBDIVISION BLOCK / SECTION LOT LOT AREA 1.16 ACRES SITE CLASS PS DESIGN FLOW 360 L.T.A.R. 0.30 GPD/FT

Septic Tank: 1000 Gallons; STB 794 Date 2-26-99

Pump Tank: Gallons; PT Date

Pump Make: Model Serial No.

Nitrification Field: No Fields 1 Square Feet 1200 Linear Feet 400

No Lines FIVE Trench Width 36" Max Trench Bottom Depth 30"

☑ New System ☐ Repair System Type: I II III IV V VI

System Description: CONVENTIONAL GRAVITY

Repair System Description: CONV. GRAVITY

Maintenance Agreement Required: ☐ Yes ☑ No

Gravel Depth 12" ☐ Slab ☑ Crawl Space ☐ Basement w/plumbing ☐ Basement wo/plumbing

☑ House/Mod. Home No. Bedrooms 3

☑ Mobile Home No. Bathrooms 2

☐ Business No. Employees


☐ Other

Water Supply: ☐ Individual ☑ Public ☐ Community


Comments/Conditions:

Comments/Conditions SEPTIC TANK WITH MARKER INSTALLED USING "POLYLOK" FILTER

INITIAL SITE SKETCH

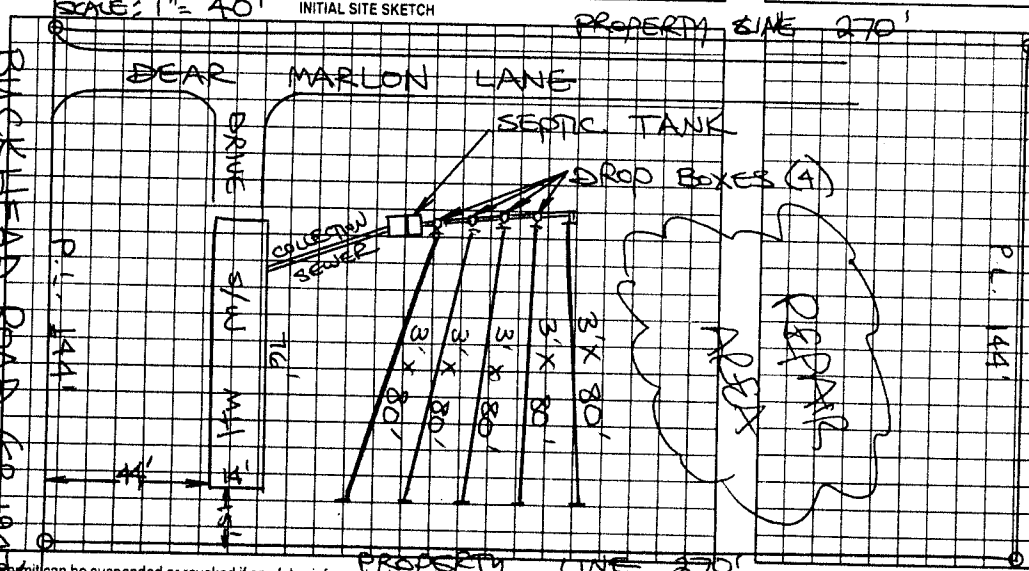

AS BUILT SKETCH

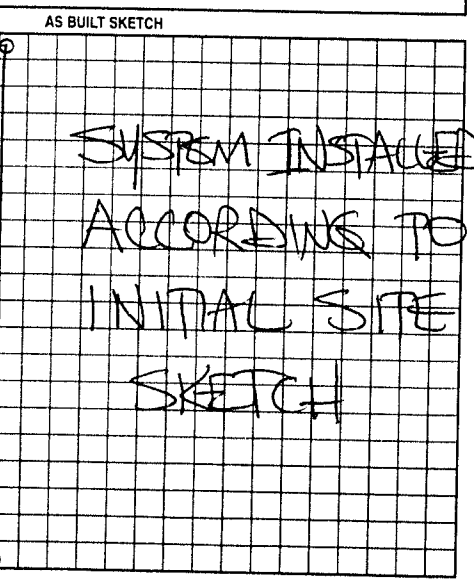

Permit can be suspended or revoked if any false information is supplied toward securing the permit/any unauthorized changes are made to the site/any unauthorized changes are made in the installation of the system. Improvement Permit with plat valid without expiration. Improvement Permit with site plan valid for sixty months. Authorization to Construct is valid for a period equal to that of Improvement Permit – not to exceed sixty months.

Signed: [signature] date 5/18/99 Installed by: ATLANTIC EXCAVATING

Improvement Permit by: STEVE HEDRICK date 5-18-99 Operation Permit by: STEVE HEDRICK date 5-20-99

Authorization to Construct by: STEVE HEDRICK date 5-18-99 Existing System Inspection by: date

HEALTH DEPT. COPY: WHITE OWNER COPY (FINAL): YELLOW OWNER COPY (INITIAL): PINK