Computer 12N-A-3

IREDELL COUNTY HEALTH DEPARTMENT

STATESVILLE 704-878-5305 MOORESVILLE 704-664-5281

IMPROVEMENT PERMIT / CERTIFICATE OF COMPLETION / OPERATION PERMIT / EXISTING SYSTEM INSPECTION

PROPERTY DESCRIPTION NO. 22899 DATE 12-20-95 TAX MAP NO. PART OF 12N-A-24 Watershed: ☐ Yes ☒ No

OWNER OR CONTRACTOR JACK T. MOORE PHONE: Business _____ Home 872-1760

ADDRESS 3944 WILKESBORO ROAD STATESVILLE NC 28677

LOCATION US 21 N TO TOMLIN RD, TL HICKORY GROVE, TL BUCKHEAD RD, 3RD LOT ON LEFT

SUBDIVISION WELCH ACRES BLOCK / SECTION _____ LOT 3 LOT AREA 2.0 ACRES SITE CLASS PS DESIGN FLOW 360 L.T.A.R. 0.30 GPD/FT²

Septic Tank: 1000 Gallons; STB 854 Date 11/7/95

Pump Tank: _____ Gallons; PT _____ Date _____

Pump Make: _____ Model _____ Serial No. _____

Nitrification Field: No Fields 1 Square Feet 1200 Linear Feet 400

No Lines 5 Trench Width 36" Max Trench Bottom Depth (24") Gravel Depth 12"

☒ New System ☐ Repair System Type: I, (II), III, IV, V, VI

System Description: CONVENTIONAL GRAVITY

Repair System Description: STANDARD GRAVITY

Maintenance Agreement Required: ☐ Yes ☐ No

☐ House/Mod. Home ☒ Mobile Home ☐ Business ☐ Other

No. Bedrooms ____ No. Bathrooms ____ No. Employees ____


☐ Slab ☒ Crawl Space ☐ Basement w/plumbing ☐ Basement wo/plumbing

Water Supply: ☐ Individual ☐ Community ☒ Public


Comments: ① REMOVE EXISTING FIELD TERRACE ② KEEP SYSTEM MINIMUM 5' FROM MH, 10' FROM PROPERTY LINE ③ INSTALL LINES AS FLAGGED ON CONTOUR, USING SERIAL DISTRIBUTION ④ MAX TRENCH BOTTOM DEPTH = 24".

Comments:

INITIAL SITE SKETCH

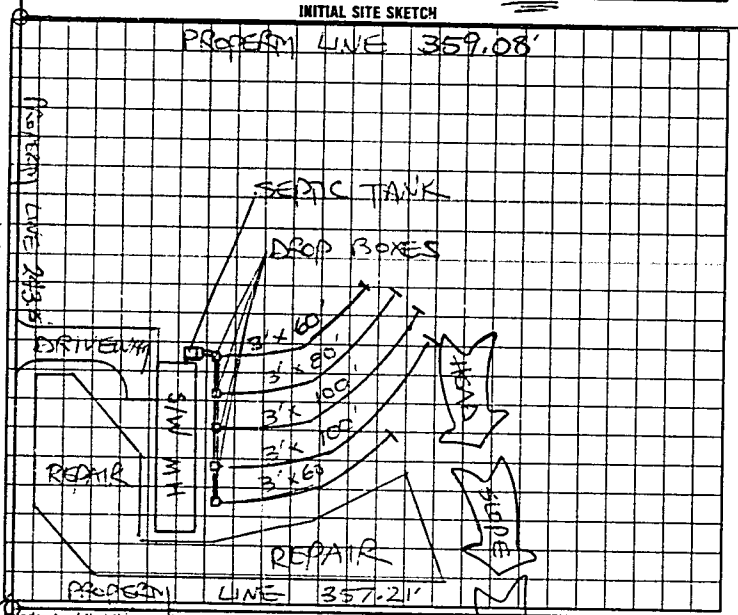

AS BUILT SKETCH

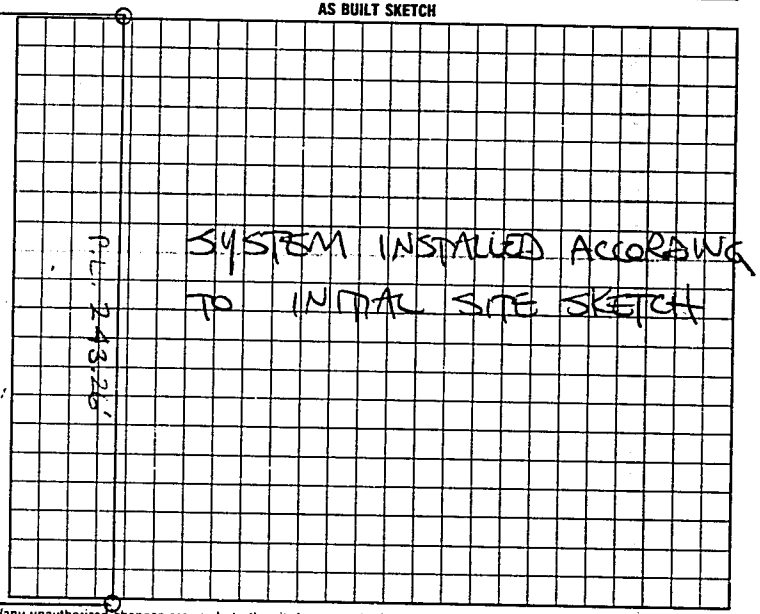

BUCKHEAD ROAD (SR 1947)

I understand that this permit can be suspended or revoked if any false information is supplied toward securing the permit/any unauthorized changes are made to the site/any unauthorized changes are made in the installation of the system.

AUTHORIZATION TO CONSTRUCT IS VALID FIVE(5) YEARS FROM DATE OF ISSUANCE. IMPROVEMENT PERMIT HAS NO EXPIRATION DATE.

Signed: Jack T Moore

Improvement Permit by: STEVE HEARICK date 12-20-95

Authorization to Construct / ~~Existing System Inspection~~ by: STEVE HEARICK date 12-20-95

Installed by: M&M DITCHING, TOM MOORE

Certificate of Completion by: _____ date _____

Operation Permit by: STEVE HEARICK date 1-5-96

HEALTH DEPT COPY WHITE | INSPECTION COPY (FINAL) GREEN | OWNER COPY (FINAL) YELLOW | INSPECTION COPY (INITIAL) PINK | OWNER COPY (INITIAL) GOLD

295100