IREDELL COUNTY HEALTH DEPARTMENT

STATESVILLE 704-878-5305 MOORESVILLE 704-664-5281

IMPROVEMENT PERMIT / CERTIFICATE OF COMPLETION / OPERATION PERMIT / EXISTING SYSTEM INSPECTION

PROPERTY DESCRIPTION NO. 22852 DATE 12-20-95 TAX MAP NO. 12N- A-24 Watershed: ☐ Yes ☑ No

OWNER OR CONTRACTOR JOHN MOORE PHONE: Business Home 876-1745

ADDRESS P.O. BOX 4 OLIN NC 28660

LOCATION US 21 N, TL TOMLIN RD, TL HICKORY GROVE, TL BUCKHEAD RD, 2ND LOT ON LEFT

SUBDIVISION WELCH ACRES BLOCK / SECTION LOT 4 LOT AREA 0.50 ACRE SITE CLASS. PS DESIGN FLOW 360 L.T.A.R. 0.3 GPD/FT²

Septic Tank: 1000 Gallons; STB 854 Date 11/7/95

Pump Tank: Gallons; PT Date

Pump Make: Model Serial No.

Nitrification Field: No Fields 1 Square Feet 1200 Linear Feet 400

No Lines 5 Trench Width 36" Max Trench Bottom Depth 18-36" Gravel Depth 12"

☑ New System ☐ Repair System Type: I (II) III. IV. V. VI

System Description: CONVENTIONAL GRAVITY

Repair System Description: CHAMBERED GRAVITY

Maintenance Agreement Required: ☐ Yes ☑ No

☐ Slab ☑ Crawl Space ☐ Basement w/plumbing ☐ Basement wo/plumbing

☐ House/Mod. Home ☑ Mobile Home ☐ Business ☐ Other


No. Bedrooms 3 No. Bathrooms 2 No. Employees

Water Supply: ☑ Individual ☐ Community ☑ Public

Comments: ① KEEP SYSTEM MINIMUM 5' FROM MH 10' FROM PROPERTY LINE ② INSTALL LINES ON CONTOUR AS SHOWN, USING SERIAL DISTRIBUTION

Comments:

INITIAL SITE SKETCH

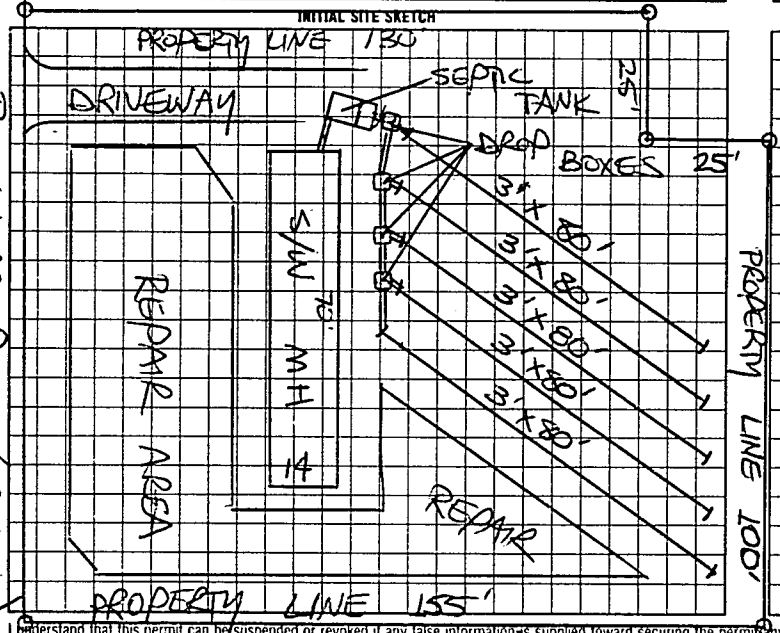

AS BUILT SKETCH

SYSTEM INSTALLED ACCORDING TO INITIAL SITE SKETCH

I understand that this permit can be suspended or revoked if any false information is supplied toward securing the permit, any unauthorized changes are made to the site/any unauthorized changes are made in the installation of the system.

AUTHORIZATION TO CONSTRUCT IS VALID FIVE (5) YEARS FROM DATE OF ISSUANCE. IMPROVEMENT PERMIT HAS NO EXPIRATION DATE.

Signed: X John Moore Installed by: M & M DITCHING, TOM MOORE

Improvement Permit by: STEVE HEDRICK date 12-20-95 ~~Certificate of Completion by:~~ date

AUTHORIZATION TO CONSTRUCT Existing System Inspection by: STEVE HEDRICK date 12-20-95 Operation Permit by: STEVE HEDRICK date 1-5-96

HEALTH DEPT. COPY: WHITE INSPECTION COPY (FINAL): GREEN OWNER COPY (FINAL): YELLOW INSPECTION COPY (INITIAL): PINK OWNER COPY (INITIAL): GOLD

5 9 5 1 0 0