IREDELL COUNTY HEALTH DEPARTMENT

STATESVILLE 704-878-5305 MOORESVILLE 704-664-5281

IMPROVEMENT PERMIT / CERTIFICATE OF COMPLETION / OPERATION PERMIT / EXISTING SYSTEM INSPECTION

PROPERTY DESCRIPTION NO. 068801 DATE 8-15-97 TAX MAP NO. 4870 25 5730 Watershed: ☐ Yes ☑ No

OWNER OR CONTRACTOR JOHN E. MOORE PHONE: Business c/o 873-1014 Home 876-1745

ADDRESS P.O. BOX 4 OLIN NC 28660

LOCATION US 21 N TO TOMLIN, TL HICKORY GROVE, LOT ON LEFT AT BUCKHEAD ROAD

SUBDIVISION WELCH ACRES BLOCK / SECTION ____ LOT 5 LOT AREA 0.78 ACRE SITE CLASS. PS DESIGN FLOW 360 L.T.A.R. 0.30 GPD/FT²

Septic Tank: 1000 Gallons; STB 620 Date 5-23-97

Pump Tank: ____ Gallons; PT ____ Date ____

Pump Make: ____ Model ____ Serial No. ____

Nitrification Field: No Fields 1 Square Feet 1200 Linear Feet 400

No Lines FOUR Trench Width 36" Max Trench Bottom Depth 36" Gravel Depth 12"

☑ New System ☐ Repair System Type: I, II, III, IV, V, VI

System Description: CONV. GRAVITY

Repair System Description: CONV. GRAVITY

Maintenance Agreement Required: ☐ Yes ☑ No

☐ House/Mod. Home No. Bedrooms 3

☑ Mobile Home No. Bathrooms 2

☐ Business No. Employees ____

☐ Other ____

☐ Slab ☑ Crawl Space ☐ Basement w/plumbing ☐ Basement wo/plumbing


Water Supply: ☐ Individual ☐ Community ☑ Public

Comments:

Comments:

SCALE: 1" = 40'

INITIAL SITE SKETCH

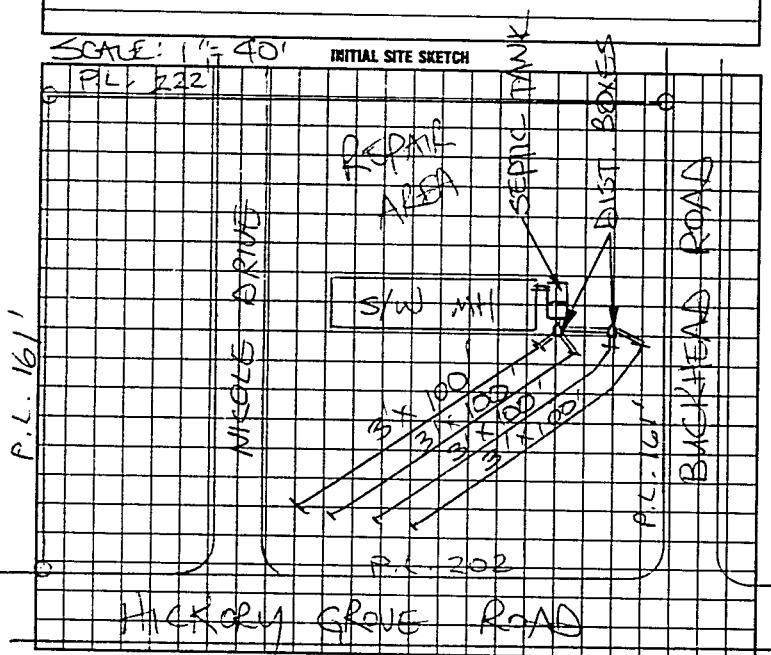

AS BUILT SKETCH

Installed as shown

I understand that this permit can be suspended or revoked if any false information is supplied toward securing the permit/any unauthorized changes are made to the site/any unauthorized changes are made in the installation of the system. Improvement Permit is valid ~~for~~ 60 months from date of issuance. AUTHORIZATION TO CONSTRUCT IS VALID FOR 60 MONTHS FROM DATE OF ISSUANCE

Signed: ____

Improvement Permit by: STEVE HEDRICK date 8-15-97

AUTH-TO CONST Existing System Inspection by: STEVE HEDRICK date 8-15-97

Installed by: Sammy Reavis

~~Certificate of Completion by:~~ ____ date ____

Operation Permit by: Mark C. Ayers date 8-21-97

HEALTH DEPT. COPY: WHITE INSPECTION COPY (FINAL): GREEN OWNER COPY (FINAL): YELLOW INSPECTION COPY (INITIAL): PINK OWNER COPY (INITIAL): GOLD

068801