IREDELL COUNTY HEALTH DEPARTMENT

STATESVILLE 704-878-5305 MOORESVILLE 704-664-5281

IMPROVEMENT PERMIT / AUTHORIZATION TO CONSTRUCT / OPERATION PERMIT / EXISTING SYSTEM INSPECTION

PERMIT# 078019 PIN# 4870 25 6405 DATE 12-3-98

OWNER OR CONTRACTOR JACK T. MOORE PHONE: Business Home 876-4271

ADDRESS 3944 WILKESBORO HWY, STATESVILLE, NC 28625

LOCATION US 21 N, TL TOMLIN ROAD, TL HICKORY GROVE, TL BUCKHEAD, 3RD LOT ON LEFT

SUBDIVISION BLOCK / SECTION LOT LOT AREA 0.80 ACRE SITE CLASS PS DESIGN FLOW 360 L.T.A.R. 0.30 GPD/FT²

Septic Tank: 1000 Gallons: STB 854 Date 10-7-98

Pump Tank: Gallons: PT Date

Pump Make Model Serial No

Nitrification Field: No Fields 1 Square Feet EQ TO 1200 Linear Feet 300

No Lines FOUR Trench Width: 36" Max Trench Bottom Depth 36" Depth: 6"

✓ New System Repair System Type: I II (III) IV V VI

System Description 259- REDUCTION GRAVITY

Repair System Description 252- REDUCTION GRAVITY

Maintenance Agreement Required: Yes ✓ No

House/Mod. Home ✓ Mobile Home Business Other

No. Bedrooms 3 No. Bathrooms 2 No. Employees


Water Supply: ☐ Individual ✓ Public ☐ Community

Slab ✓ Crawl Space Basement w/plumbing Basement wo/plumbing


Comments/Conditions: INSTALL FORTY-EIGHT (48) CHAMBERS IN FOUR EQUAL LENGTH LINES ON CONTOUR AS SHOWN (OWNER'S REQUEST)

Comments Continued:

INITIAL SITE SKETCH SCALE: 1" = 40'

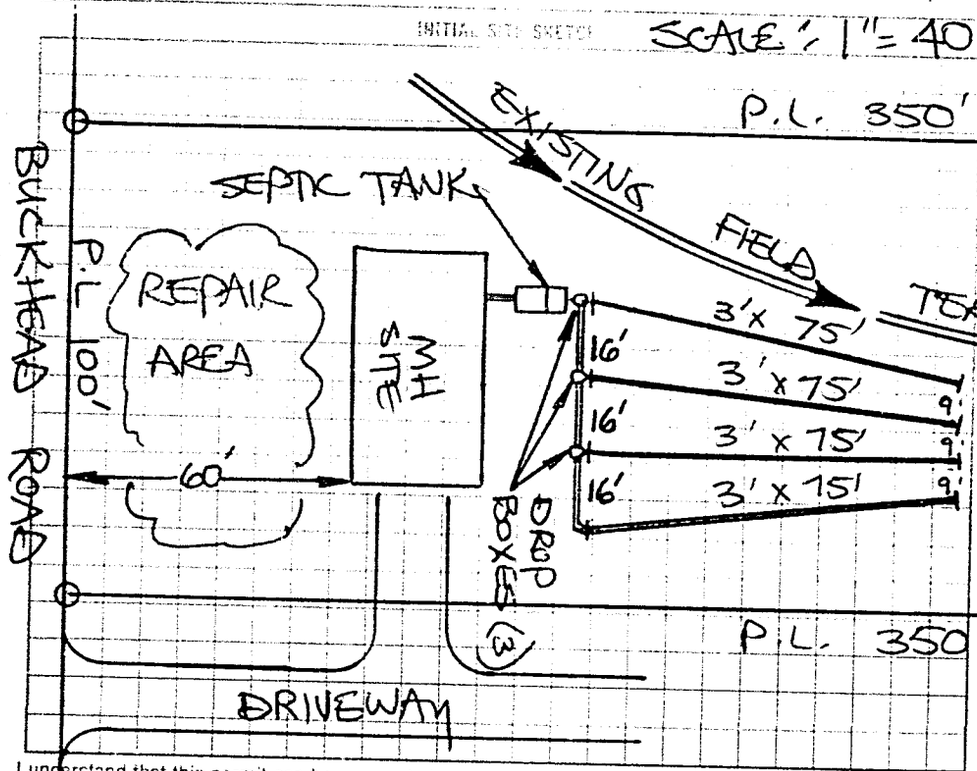

AS BUILT SKETCH

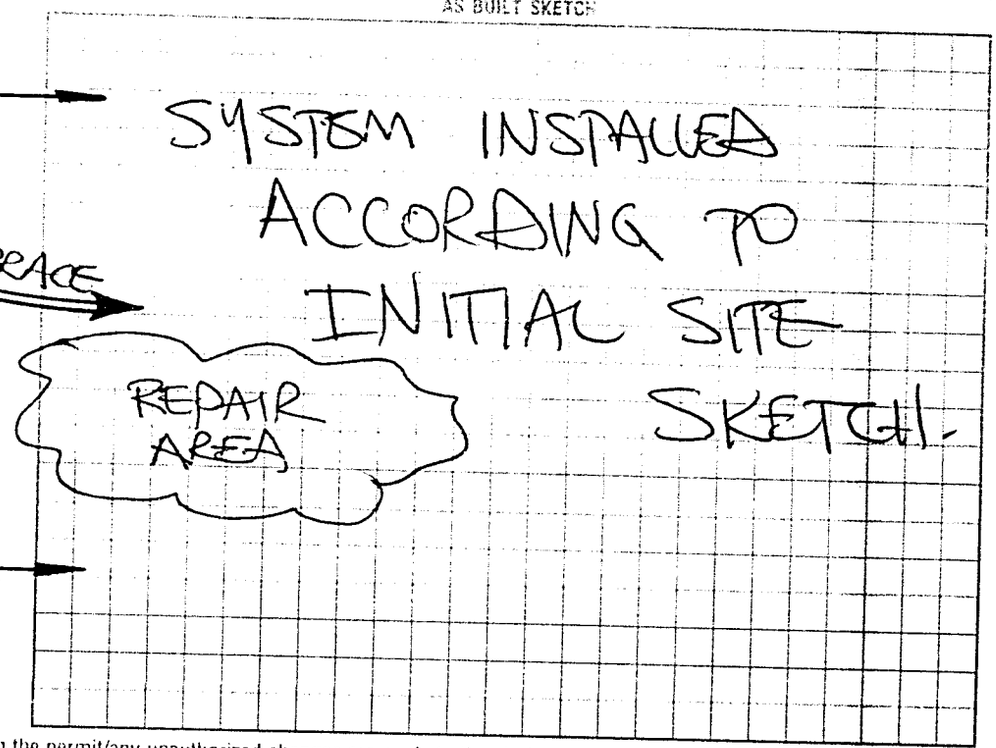

I understand that this permit can be suspended or revoked if any false information is supplied toward securing the permit/any unauthorized changes are made to the site/any unauthorized changes are made in the installation of the system. Improvement Permit with plat valid without expiration. Improvement Permit with site plan valid for sixty months. Authorization to Construct is valid for a period equal to that of Improvement Permit – not to exceed sixty months.

Signed: Jack Moore date 12-3-98

Improvement Permit by: STEVE HEDRICK date 12-3-98

Authorization to Construct by: STEVE HEDRICK date 12-3-98

Installed by: TOM MOORE'S HAULING (MORAVIAN FALLS)

Operation Permit by: STEVE HEDRICK date 12-10-98

Existing System Inspection by: date

HEALTH DEPT. COPY WHITE INSPECTION COPY (FINAL) GREEN OWNER COPY (FINAL) YELLOW INSPECTION COPY (INITIAL) PINK OWNER COPY (INITIAL) BLUE