IREDELL COUNTY HEALTH DEPARTMENT

STATESVILLE 704-878-5305 MOORESVILLE 704-664-5281

IMPROVEMENT PERMIT / CERTIFICATE OF COMPLETION / OPERATION PERMIT / EXISTING SYSTEM INSPECTION

PROPERTY DESCRIPTION NO. 25612 DATE 12-6-96 TAX MAP NO. 12N-A-24 Watershed: ☐ Yes ☑ No

OWNER OR CONTRACTOR JACK T. MOORE PHONE: Business _____ Home _____

ADDRESS 3944 WILKESBORO HWY, STATESVILLE, NC 28677

LOCATION US 21 N, TL TOMLIN RD TL, HICKORY GROVE, TL BUCKHEAD 2ND LOT ON LEFT, 200' BACK

SUBDIVISION _____ BLOCK / SECTION _____ LOT 9 LOT AREA 0.517 AC. SITE CLASS. PS DESIGN FLOW 360 L.T.A.R. 0.30 GPD/FT²

Septic Tank: 1000 Gallons; STB 1012 Date 9-31-96

Pump Tank: _____ Gallons; PT _____ Date _____

Pump Make: _____ Model _____ Serial No. _____

Nitrification Field: No. Fields 1 Square Feet 1200 Linear Feet 400

No. Lines FOUR Trench Width 36" Max Trench Bottom Depth 30-36" Gravel Depth 12"

☑ New System ☐ Repair System Type: I, II, IV, V, VI

System Description: CONV. GRAVITY

Repair System Description: PDPS, GRAV. / PUMP

Maintenance Agreement Required: ☐ Yes ☑ No

☐ House/Mod. Home ☑ Mobile Home ☐ Business ☐ Other

No. Bedrooms 3 No. Bathrooms 2 No. Employees _____


☐ Slab ☑ Crawl Space ☐ Basement w/plumbing ☐ Basement wo/plumbing

Water Supply: ☐ Individual ☐ Community ☑ Public

Comments: INSTALL TRENCHES 30"-36" DEEP.

Comments:

INITIAL SITE SKETCH SCALE: 1"=40'

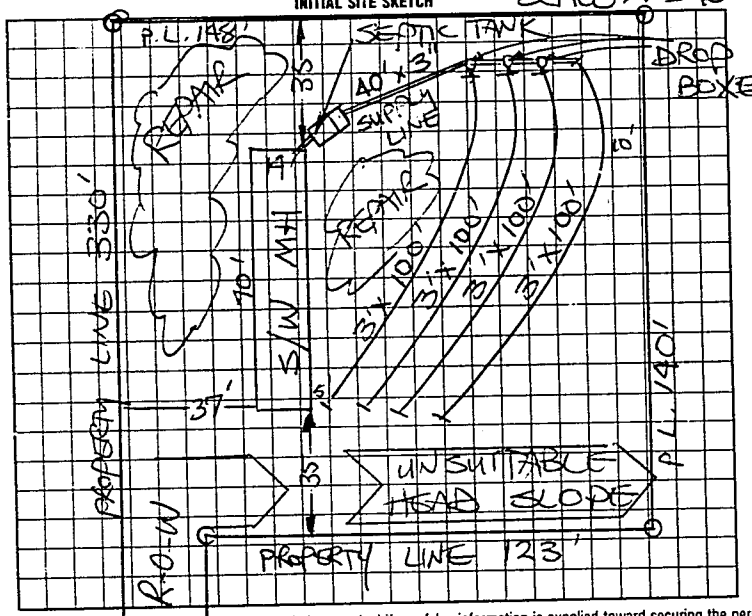

AS BUILT SKETCH

SYSTEM INSTALLED ACCORDING TO INITIAL SITE SKETCH

I understand that this permit can be suspended or revoked if any false information is supplied toward securing the permit/any unauthorized changes are made to the site/any unauthorized changes are made in the installation of the system. Improvement Permit is valid for 60 months from date of issuance. AUTH. TO CONST. IS VALID FOR A PERIOD EQUAL TO THE I.P. NOT TO EXCEED 5 YEARS.

Signed: Jack T Moore Installed by: KENNY MADISON

Improvement Permit by: STEVE HENDRICK date 12-6-96 ~~Certificate of Completion by:~~ _____ date _____

AUTH. TO CONST. ~~Existing System Inspection by:~~ STEVE HENDRICK date 12-6-96 Operation Permit by: STEVE HENDRICK date 12-16-96

HEALTH DEPT. COPY: WHITE INSPECTION COPY (FINAL): GREEN OWNER COPY (FINAL): YELLOW INSPECTION COPY (INITIAL): PINK OWNER COPY (INITIAL): GOLD

8551 00