IREDELL COUNTY HEALTH DEPARTMENT

STATESVILLE 704-878-5305 MOORESVILLE 704-664-5281

IMPROVEMENT PERMIT / CERTIFICATE OF COMPLETION / OPERATION PERMIT / EXISTING SYSTEM INSPECTION

PROPERTY DESCRIPTION NO. 3621 / 06512 DATE 3-17-97 TAX MAP NO. 4870 35 0724 Watershed: ☐ Yes ☒ No

OWNER OR CONTRACTOR CECIL COMBS PHONE: Business Home 546-7903

ADDRESS 123 HICKORY GROVE ROAD, HARMONY, NC 28634

LOCATION US 21 N, TL TOMLIN[illegible] RD, TL HICKORY GROVE RD, 3RD DRIVEWAY ON LEFT

SUBDIVISION BLOCK / SECTION LOT LOT AREA 2.60 ACRES SITE CLASS. PS DESIGN FLOW 360 L.T.A.R. 0.33 GPD/FT²

Septic Tank: 1000 Gallons; STB 1012 Date 3-16-97

Pump Tank: Gallons; PT Date

Pump Make: Model Serial No.

Nitrification Field: No Fields 1 Square Feet 1080 Linear Feet 360

No Lines FOUR Trench Width 36" Max Trench Bottom Depth 36" Gravel Depth 12"

☒ New System ☐ Repair System Type: I, II, III, IV, V, VI

System Description: CONVENTIONAL GRAVITY

Repair System Description: COND. PUMP

Maintenance Agreement Required: ☐ Yes ☒ No

☐ House/Mod. Home No. Bedrooms 3

☐ Mobile Home No. Bathrooms 2

☐ Business No. Employees

☐ Other


☐ Slab ☒ Crawl Space ☐ Basement w/plumbing ☐ Basement wo/plumbing

Water Supply:
☐ Individual
☐ Community
☒ Public


Comments:

Comments:

INITIAL SITE SKETCH

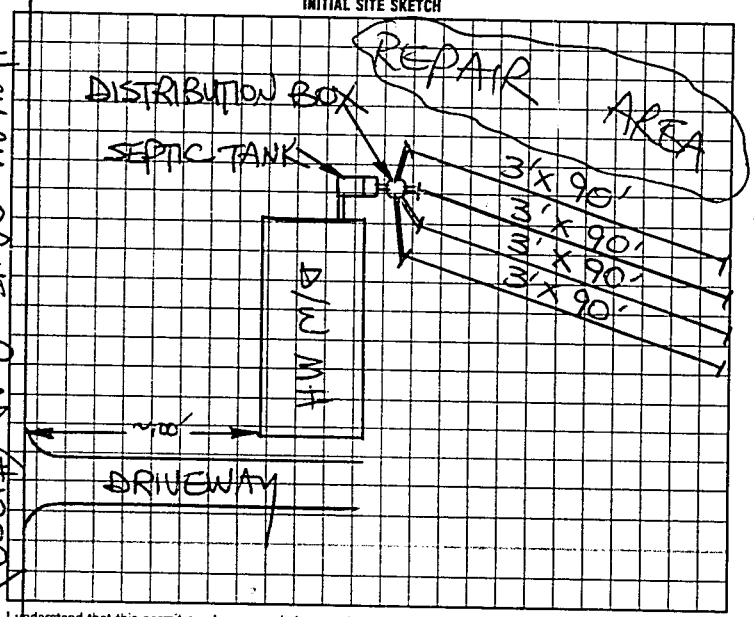

AS BUILT SKETCH

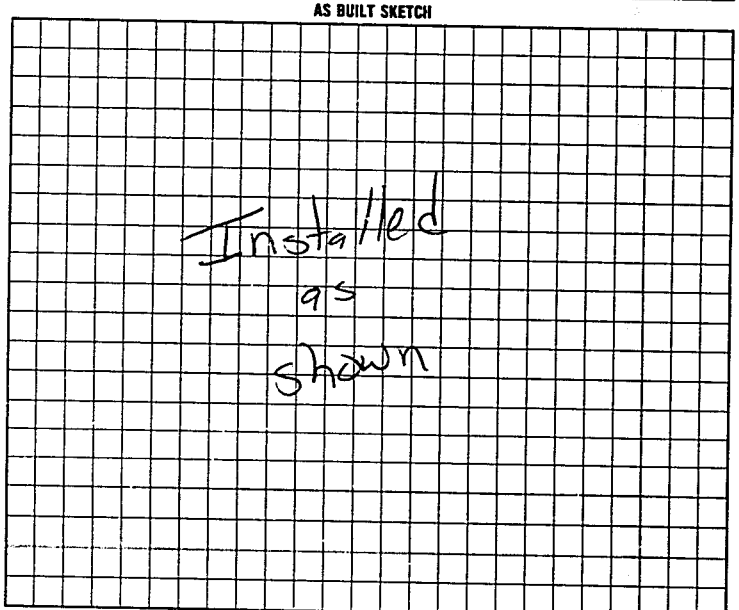

I understand that this permit can be suspended or revoked if any false information is supplied toward securing the permit/any unauthorized changes are made to the site/any unauthorized changes are made in the installation of the system. Improvement Permit is valid for 60 months from date of issuance. AUTHORIZATION TO CONSTRUCT IS VALID FOR 60 MONTHS FROM DATE OF ISSUANCE.

Signed: + Cecil T. Combs

Improvement Permit by: STEVE HEDRICK date 3-17-97

AUTH. TO CONST.

Existing System Inspection by: STEVE HEDRICK date 3-17-97

Installed by: Steve Jordon

~~Certificate of Completion by~~ date

Operation Permit by: Mary C. Ostis date 5-21-97

HEALTH DEPT. COPY: WHITE INSPECTION COPY (FINAL): GREEN OWNER COPY (FINAL): YELLOW INSPECTION COPY (INITIAL): PINK OWNER COPY (INITIAL): GOLD