IREDELL COUNTY HEALTH DEPARTMENT

STATESVILLE 704-878-5305 MOORESVILLE 704-664-5281

IMPROVEMENT PERMIT / AUTHORIZATION TO CONSTRUCT / OPERATION PERMIT / EXISTING SYSTEM INSPECTION

PERMIT# 102472 PIN# 4870-26-3398 DATE 10-2-01

OWNER OR CONTRACTOR TANDRA GRANT PHONE: Business Home (704) 876-3366

ADDRESS 258 BAILEY FARM RD, STATESVILLE NC 28625

LOCATION US 21 North, TL TOMLIN ROAD, 0.6 MILE ON LEFT

SUBDIVISION BLOCK / SECTION LOT LOT AREA 2.0 ACRES SITE CLASS PS DESIGN FLOW 360 L.T.A.R. 0.40 gpd/ft²

Septic Tank: 1000 Gallons; STB 1012 Date 9-8-01
Pump Tank: Gallons; PT Date
Pump Make: Model Serial No.
Nitrification Field: No Fields 1 Square Feet 900 Linear Feet 300
No Lines THREE Trench Width 36" Max Trench Bottom Depth 36" Gravel Depth 12"

☑ New System ☐ Repair System Type: I II III IV V VI
System Description: CONVENTIONAL GRAVITY
Repair System Description: CONVENTIONAL GRAVITY
Maintenance Agreement Required: ☐ Yes ☑ No
☐ Slab ☑ Crawl Space ☐ Basement w/plumbing ☐ Basement wo/plumbing


☐ House/Mod. Home No. Bedrooms 2
☑ Mobile Home No. Bathrooms 2
☐ Business No. Employees
☐ Other

Water Supply: ☐ Individual ☑ Public ☐ Community

Comments/Conditions:

Comments/Conditions:
- poly 16K filter Installed
- Septic Tank Marker Installed

INITIAL SITE SKETCH

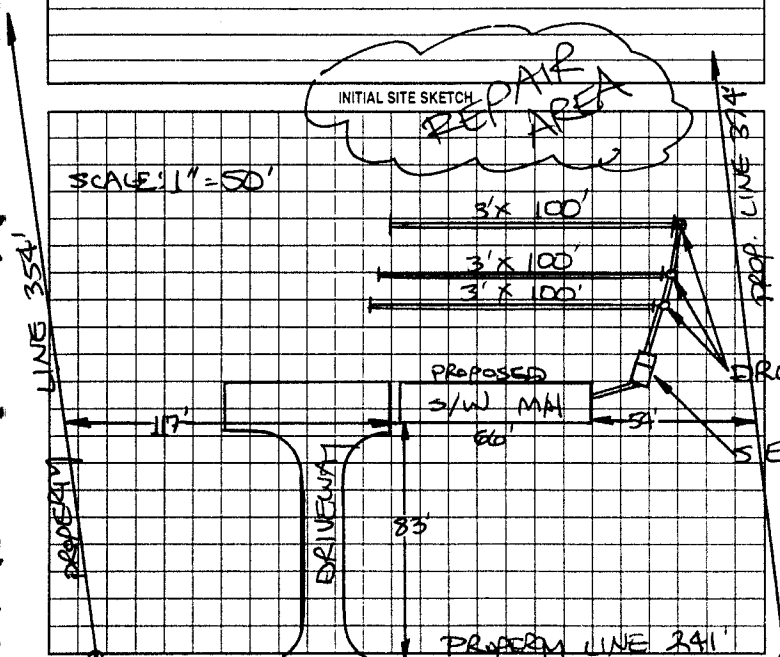

AS BUILT SKETCH

Installed as Shown per Initial Site Sketch

Permit can be suspended or revoked if any false information is supplied toward securing the permit; any unauthorized changes are made to the site; any unauthorized changes are made in the installation of the system. Improvement Permit with plat valid without expiration. Improvement Permit with site plan valid for sixty months. Authorization to Construct is valid for a period equal to that of Improvement Permit – not to exceed sixty months.

Signed: Henry Tomei date 10-2-01 Installed by: Tommy Frye

Improvement Permit by: STEVE HEDRICK date 10-2-01 Operation Permit by: William O. Johnson date 10/10/01

Authorization to Construct by: STEVE HEDRICK date 10-2-01 Existing System Inspection by: date

HEALTH DEPT COPY WHITE OWNER COPY (FINAL) YELLOW OWNER COPY (INITIAL) PINK