IREDELL COUNTY HEALTH DEPARTMENT

STATESVILLE 704-878-5305 MOORESVILLE 704-664-5281

IMPROVEMENT PERMIT / AUTHORIZATION TO CONSTRUCT / OPERATION PERMIT / EXISTING SYSTEM INSPECTION

PERMIT# 079795 PIN# 4870 26 6157 DATE 3-26-99

OWNER OR CONTRACTOR JASON HARRIS PHONE: Business Home 546-2646

ADDRESS 140 HICKORY GROVE ROAD HARMONY NC 28634

LOCATION US 21 N, TL TOMLIN ROAD, ON LEFT PAST HICKORY GROVE ROAD.

SUBDIVISION BLOCK / SECTION LOT LOT AREA 4.76 ACRES SITE CLASS PS DESIGN FLOW 360 L.T.A.R. 0.30 gpd/ft²

Septic Tank: 1000 Gallons; STB 680 Date 4-12-99

Pump Tank: Gallons; PT Date

Pump Make: Model Serial No.

Nitrification Field: No Fields 1 Square Feet Eq. to 1200 Linear Feet 300+

No Lines FOUR Trench Width 36" Max Trench Bottom Depth 36"

☑ New System ☐ Repair System Type: I II III IV V VI

System Description: 25% REDUCTION GRAVITY

Repair System Description: MAX. FEASIBLE, PUMP RD

Maintenance Agreement Required: ☐ Yes ☑ No

Gravel Depth 6" SAND ☐ Slab ☐ Crawl Space ☐ Basement w/plumbing ☑ Basement wo/plumbing

☑ House/Mod. Home No. Bedrooms 3

☐ Mobile Home No. Bathrooms 2

☐ Business No. Employees


☐ Other

Water Supply: ☐ Individual ☑ Public ☐ Community

Comments/Conditions: INSTALL 25% REDUCTION SYSTEM

Comments/Conditions

INITIAL SITE SKETCH SCALE: 1"=40'

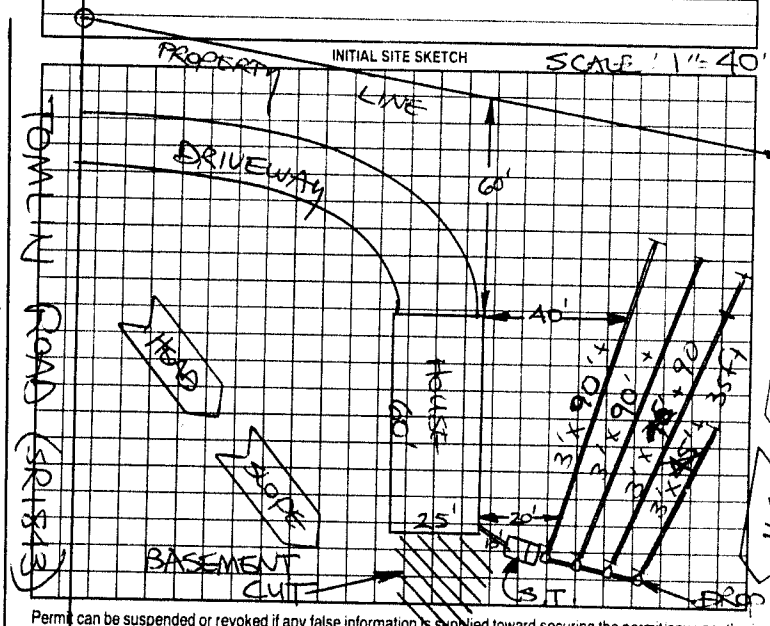

AS BUILT SKETCH

Installed as shown

Permit can be suspended or revoked if any false information is supplied toward securing the permit/any unauthorized changes are made to the site/any unauthorized changes are made in the installation of the system. Improvement Permit with plat valid without expiration. Improvement Permit with site plan valid for sixty months. Authorization to Construct is valid for a period equal to that of Improvement Permit – not to exceed sixty months.

Signed _____ date 7-30-99 Installed by: K & L

Improvement Permit by: STEVE HEDRICK date 3-26-99 Operation Permit by: [illegible] COUNTY RS date 6-18-99

Authorization to Construct by: STEVE HEDRICK date 3-26-99 Existing System Inspection by: _____ date _____

HEALTH DEPT COPY WHITE OWNER COPY (FINAL) YELLOW OWNER COPY (INITIAL) PINK