IREDELL COUNTY HEALTH DEPARTMENT

This permit void 1-13-98 permit

STATESVILLE 704-878-5305 MOORESVILLE 704-664-5281

IMPROVEMENT PERMIT / AUTHORIZATION TO CONSTRUCT / OPERATION PERMIT / EXISTING SYSTEM INSPECTION

PERMIT# Repair PIN# DATE 3-9-98

OWNER OR CONTRACTOR Wayne Elledge PHONE: Business Home 876-9029

ADDRESS 242 Tomlin Rd. Harmony

LOCATION 21N TL Tomlin House on @ ~1½ mile

SUBDIVISION BLOCK / SECTION LOT LOT AREA SITE CLASS. DESIGN FLOW L.T.A.R.

Septic Tank: 1000 Gallons; STB 928/620 Date 10-7-97

Pump Tank: Gallons; PT Date

Pump Make: Model Serial No.

Nitrification Field: No Fields 1 Square Feet Linear Feet 330

No Lines 4 Trench Width 36in Max Trench Bottom Depth 36in Gravel Depth 12in

☐ New System ☒ Repair System Type: I, ☒ II, III, IV, V, VI

System Description:

Repair System Description: Gravity Conventional

Maintenance Agreement Required: ☐ Yes ☒ No

☒ House/Mod. Home ☐ Mobile Home ☐ Business ☐ Other

No. Bedrooms 4 No. Bathrooms 3 No. Employees

Water Supply: ☒ Individual ☒ Public ☐ Community

☐ Slab ☐ Crawl Space ☒ Basement w/plumbing ☐ Basement wo/plumbing


Comments:/Conditions:

Basement Plumbing split off to old system, keep New system 50ft from well, on contour. Need to disconnect waterline, Landscape & smooth out terrace


Comments:/Conditions:

redirect gutter drains

INITIAL SITE SKETCH

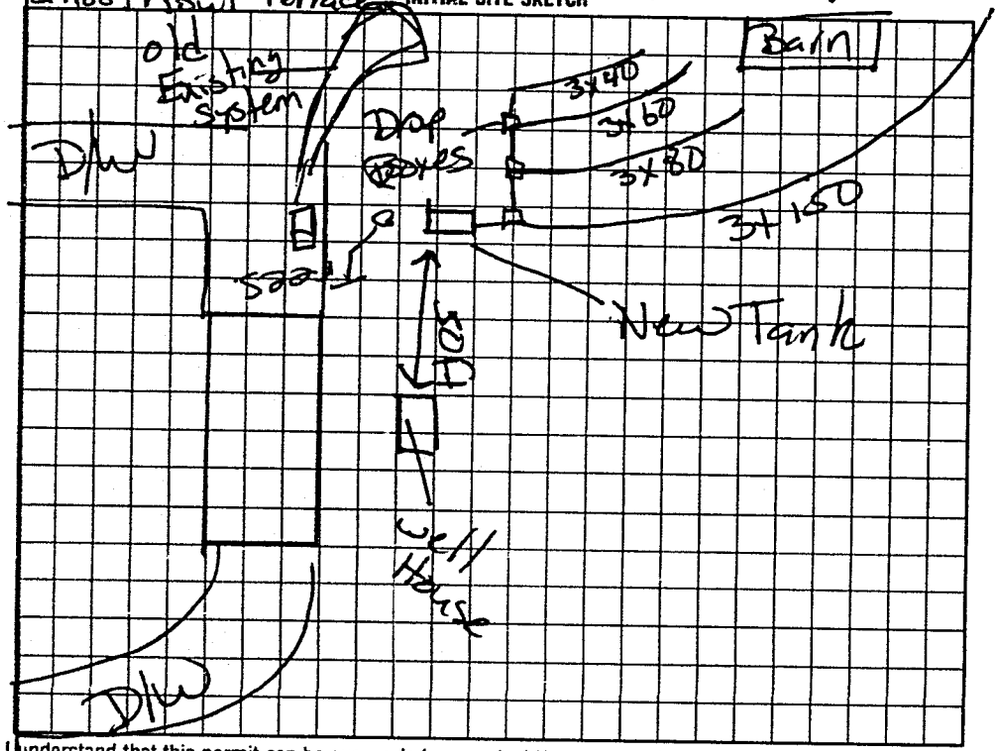

AS BUILT SKETCH

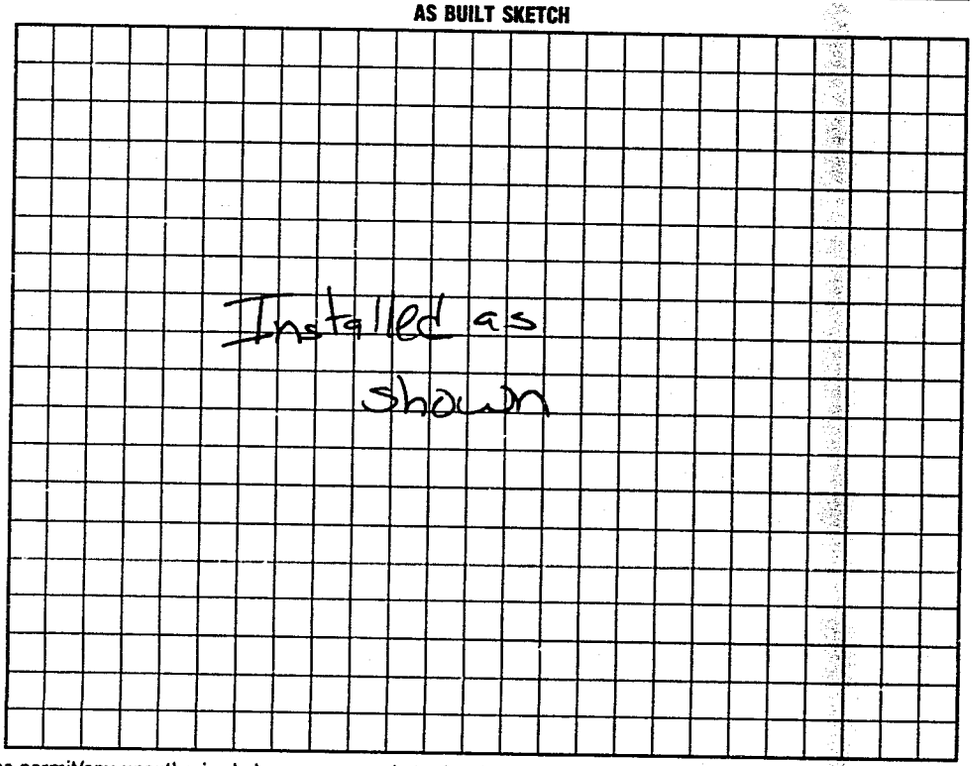

I understand that this permit can be suspended or revoked if any false information is supplied toward securing the permit/any unauthorized changes are made to the site/any unauthorized changes are made in the installation of the system. Improvement Permit with plat valid without expiration. Improvement Permit with site plan valid for sixty months. Authorization to Construct is valid for a period equal to that of Improvement Permit – not to exceed sixty months.

Signed: Wayne Elledge date

Improvement Permit by: Mark Coffey RS date 3-9-98

Authorization to Construct by: Mark Coffey RS date 3-9-98

Installed by: Sammy Reavis

Operation Permit by: Mark Coffey RS date 4-13-98

Existing System Inspection by: date

HEALTH DEPT COPY: WHITE INSPECTION COPY (FINAL): GREEN OWNER COPY (FINAL): YELLOW INSPECTION COPY (INITIAL): PINK OWNER COPY (INITIAL): GOLD