IREDELL COUNTY HEALTH DEPARTMENT

STATESVILLE 704-878-5305 MOORESVILLE 704-664-5281

IMPROVEMENT PERMIT / AUTHORIZATION TO CONSTRUCT / OPERATION PERMIT / EXISTING SYSTEM INSPECTION

PERMIT # Repair PIN # 4870285432 DATE 2/11/09

OWNER or APPLICANT Buddy Gaither PHONE: Business Home:

OWNER or APPLICANT ADDRESS 118 Gaither Park Dr.

LOCATION / DIRECTIONS 77N to (R) on Hwy 901, (L) on Gaither Park Rd, last trailer on (R)

SUBDIVISION Gaither Park MHP BLOCK / SECTION n/a LOT # n/a LOT AREA DESIGN FLOW 240 L.T.A.R. .3

Septic Tank ex Gallons: STB ex Date ex

Pump Tank Gallons: P T Date

Pump Make Model Serial #

Nitrification Field No Fields 1 No Lines 2 Linear Feet ~180'

Trench Width 36" Max. Trench Bottom Depth 36" Gravel Depth n/a ☒ GRAVITY ☐ PRESSURE

☐ New System ☒ Repair ☐ Expansion System Type I (II) III IV V VI

System Description: 25% Reduction Gravity

Repair System Description:

Maintenance Agreement Required ☐ YES ☒ NO


☒ Residence No. Bedrooms 2 ☐ Business No. Persons ☐ Other No. Employees ☐ Slab ☒ Crawl Space ☐ Basement w/plumbing ☐ Basement w/o plumbing

Water Supply: ☐ Private ☒ Public ☐ Community


Comments / Conditions

Comments / Conditions

INITIAL SITE SKETCH

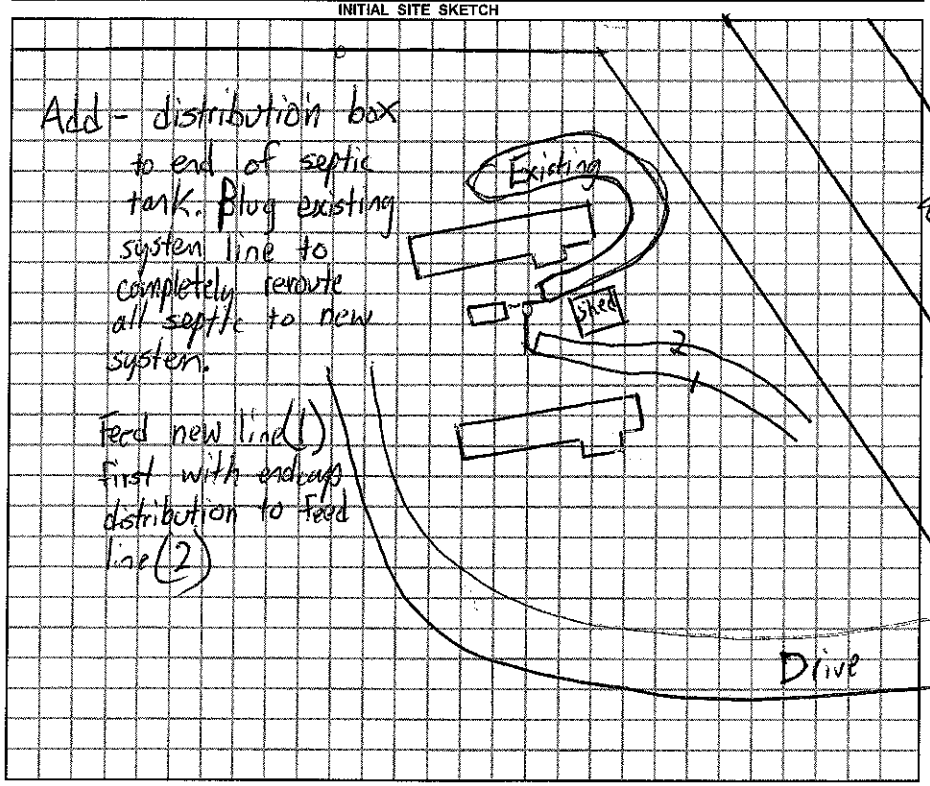

AS BUILT SKETCH

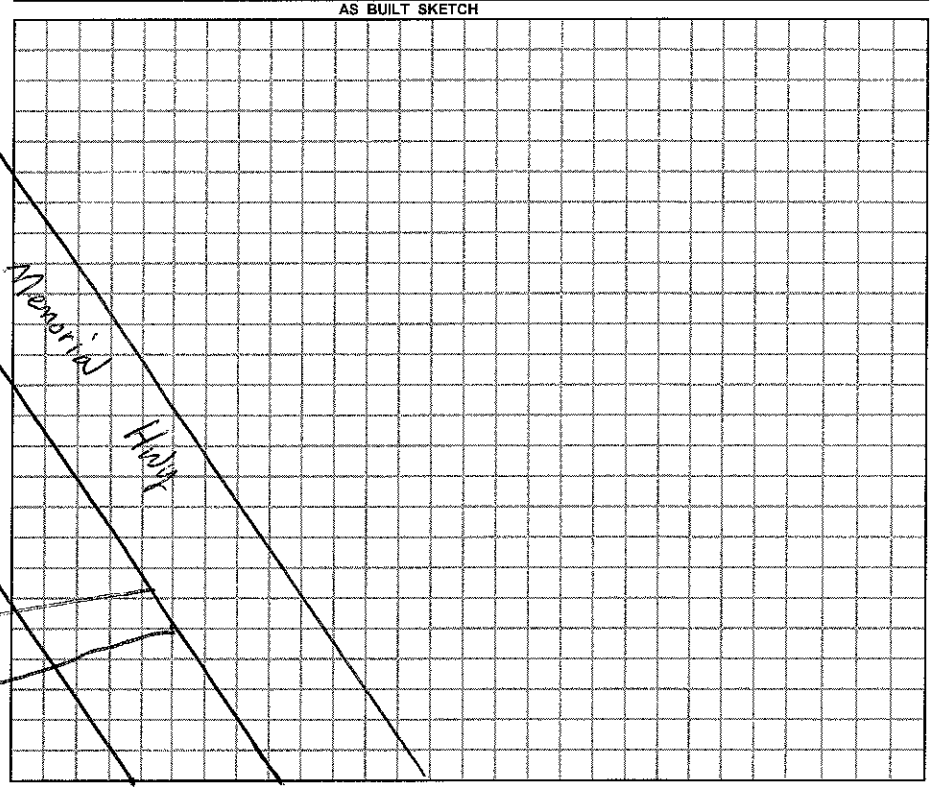

Permit can be suspended or revoked if any false information is supplied toward securing the permit / any unauthorized changes are made to the site / any unauthorized changes are made in the installation of the system.

☐ *IMPROVEMENT PERMIT w / plat valid without expiration.* ☒ *IMPROVEMENT PERMIT w / site plan valid for 60 mos.* ☒ *AUTHORIZATION TO CONSTRUCT valid for period equal to IMPROVEMENT PERMIT-not to exceed 60 mo.*

Owner / Applicant Signature: Date

Improvement Permit by: James Date 2-11-09

Authorization to Construct by: James Date 2-11-09

YOU SHOULD CONTACT A LOCATOR SERVICE PRIOR TO ANY EXCAVATION.

Installed by: Sammy Reavis

Operation Permit by: James Date: 3-31-09

Existing System Inspected by: Date:

WHITE COPY Environmental Health YELLOW COPY (Final) Owner / Applicant PINK COPY (Initial) Owner / Applicant