pd 125 8 28 97

IREDELL COUNTY HEALTH DEPARTMENT

STATESVILLE 704-878-5305 MOORESVILLE 704-664-5281

IMPROVEMENT PERMIT / CERTIFICATE OF COMPLETION / OPERATION PERMIT / EXISTING SYSTEM INSPECTION

PROPERTY DESCRIPTION NO. HARMONY DATE 8-27-97 TAX MAP NO. 0712N0000D A158 Watershed: ☐ Yes ☑ No

OWNER OR CONTRACTOR RAY LEE JOHNSON PHONE: Business Home 546-2357

ADDRESS 119 GROSE STREET, HARMONY NC 28634

LOCATION US 21 N, TL NC 901, TR GROSE STREET, 1ST LOT ON LEFT

GREASE TRAP 1000 GAL SUBDIVISION BLOCK / SECTION LOT LOT AREA 1.757 ACRES SITE CLASS. PS DESIGN FLOW 720 L.T.A.R. 0.40 GPD/FT²

Septic Tank: 1500 Gallons; STB 934 Date 3-31-98

Pump Tank: 1500 Gallons; PT 151 Date 11-3-97

Pump Make: Jet Rite Model PWS7C01A84V Serial No. 21G96W

Nitrification Field: No Fields 1 Square Feet EQ TO 1800 Linear Feet 450+

No Lines FIVE Trench Width 36" Max Trench Bottom Depth 36" Gravel Depth SAND 6"

☑ New System ☐ Repair System Type: I, II, (III) IV, V, VI

System Description: CHAMBERED, PUMP

Repair System Description: CHAMBERED, PUMP

Maintenance Agreement Required: ☐ Yes ☑ No

☐ House/Mod. Home No. Bedrooms

☐ Mobile Home No. Bathrooms 2

☑ Business No. Employees 3

☐ Other 1200 FT² FOODSTAND


Water Supply: ☐ Individual ☐ Community ☑ Public

☑ Slab ☐ Crawl Space ☐ Basement w/plumbing ☐ Basement wo/plumbing


Comments: (1) PLUMB KITCHEN WASTE INTO GREASE TRAP, ALL OTHER PLUMBING TO SEPTIC TANK (2) INSTALL SEVENTY-FIVE (75) CHAMBERS IN FIVE EQUAL LENGTH LINES (3) SEE ATTACHED SHEETS FOR PUMP & PRESSURE MANIFOLD REQUIREMENTS.

Comments: 5/6 Checked lines, set pressure.

INITIAL SITE SKETCH SCALE: 1" = 50'

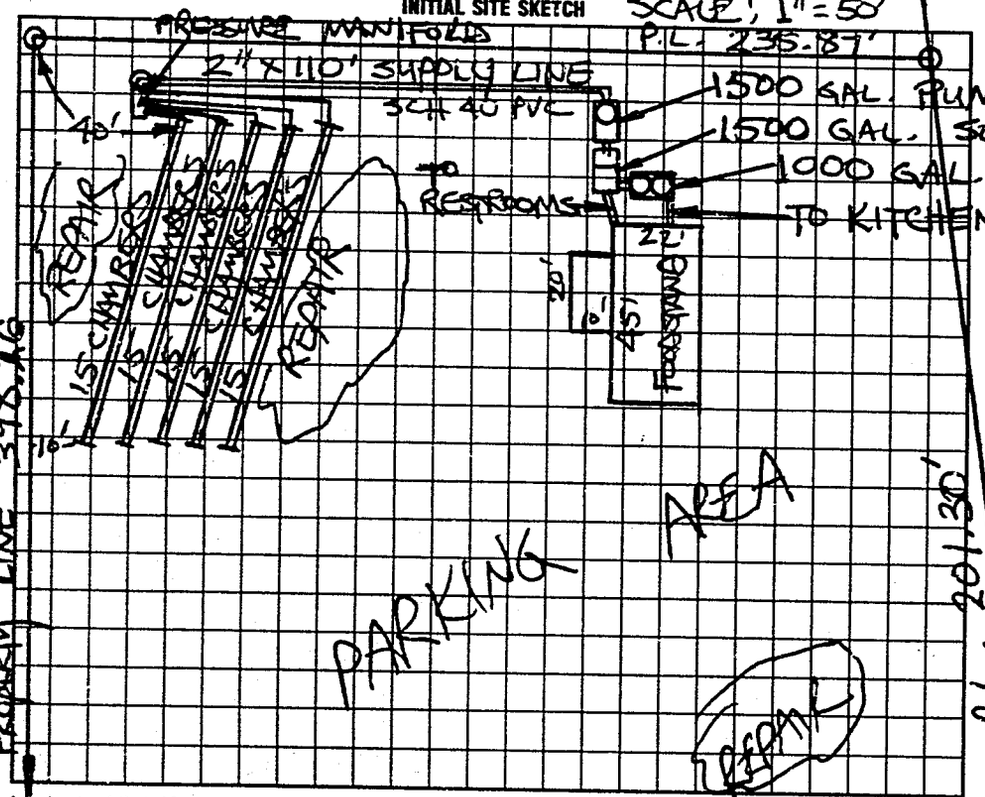

AS BUILT SKETCH

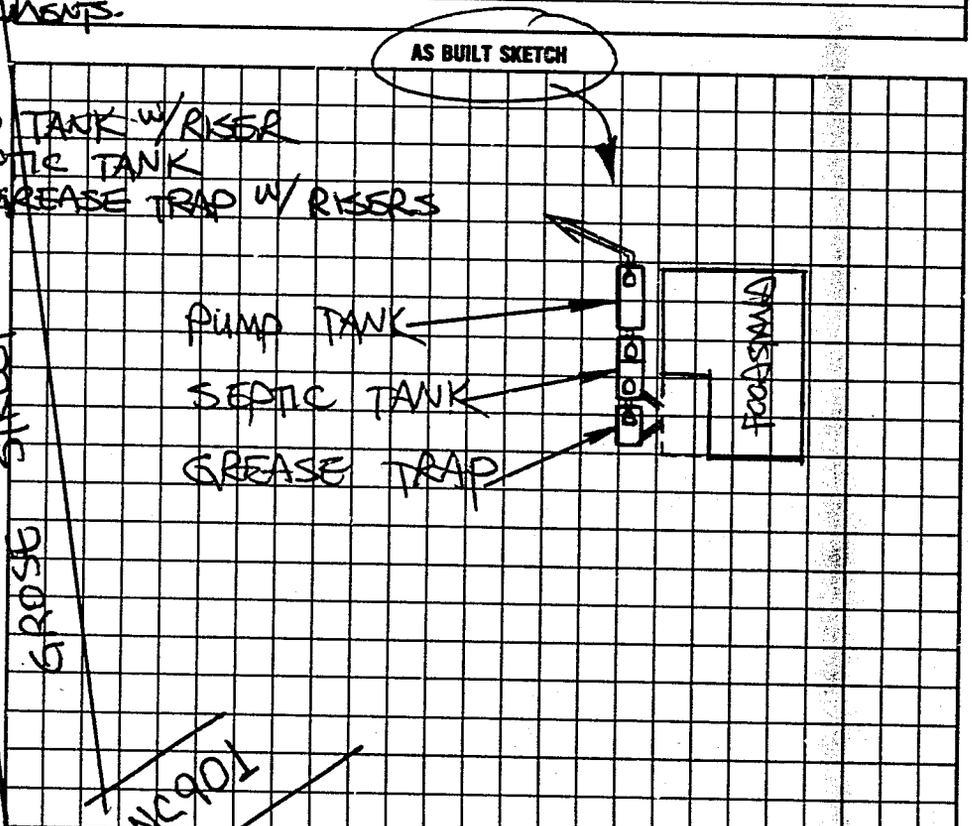

I understand that this permit can be suspended or revoked if any false information is supplied toward securing the permit/any unauthorized changes are made to the site/any unauthorized changes are made in the installation of the system. Improvement Permit is valid for 60 months from date of issuance. AUTHORIZATION TO CONSTRUCT IS VALID FOR 60 MONTHS FROM DATE OF ISSUANCE.

Signed: Ray Johnson

Improvement Permit by: STEVE HEDRICK date 8-27-97

AUTH. TO CONST. Existing System Inspection by: STEVE HEDRICK date 8-27-97

Installed by: TOMMY NIXON

Certificate of Completion by: date

Operation Permit by: STEVE HEDRICK date 5-27-98

HEALTH DEPT. COPY: WHITE INSPECTION COPY (FINAL): GREEN OWNER COPY (FINAL): YELLOW INSPECTION COPY (INITIAL): PINK OWNER COPY (INITIAL): GOLD