IREDELL COUNTY HEALTH DEPARTMENT

STATESVILLE 704-878-5305 (C) MOORESVILLE 704-664-5281

IMPROVEMENT PERMIT / AUTHORIZATION TO CONSTRUCT / OPERATION PERMIT / EXISTING SYSTEM INSPECTION

PERMIT# 119788 PIN# 4870-40-7131 DATE 5-7-04

OWNER OR CONTRACTOR KW NICHOLSON, INC PHONE: Business (704) 902-0799 Home

ADDRESS 930 ARGYLE CT. STATESVILLE NC 28677

LOCATION 21N RIGHT GLENWOOD VALLEY DR. LOT #8 ON LEFT

SUBDIVISION ~~GLENWOOD VALLEY~~ BLOCK / SECTION LOT 8 LOT AREA 1.0 SITE CLASS. PS DESIGN FLOW 480 L.T.A.R. .36PD/FT²

Septic Tank: 1000 Gallons; STB 1012 Date 7-11-04
Pump Tank: Gallons; PT Date
Pump Make: Model Serial No.
Nitrification Field: No Fields 1 Square Feet 1600 Linear Feet 400
No Lines 4 Trench Width 36" Max Trench Bottom Depth 36" Gravel Depth N/A

☑ New System ☐ Repair System Type: I, II, (III) IV, V, VI
System Description: GRAVITY 25% REDUCTION
Repair System Description: LP PANEL 50% RED.
Maintenance Agreement Required: ☐ Yes ☑ No


☑ House/Mod. Home No. Bedrooms 4
☐ Mobile Home No. Bathrooms 3
☐ Business No. Employees
☐ Other
☐ Slab ☐ Crawl Space ☑ Basement w/plumbing ☐ Basement wo/plumbing

Water Supply: ☐ Individual ☑ Public ☐ Community


Comments:/Conditions: ① INSTALL LINES ON CONTOUR ② MAINTAIN 25' FT SETBACK FROM DRAINAGE PATTERN.

Comments:/Conditions: ① SYSTEM ALTERED AS SHOWN TO FOLLOW CONTOUR W/ PRIOR HEALTH DEPT. APPROVAL ② SEPTIC TANK WITH MARKER INSTALLED USING "TUFTITE" FILTER

INITIAL SITE SKETCH

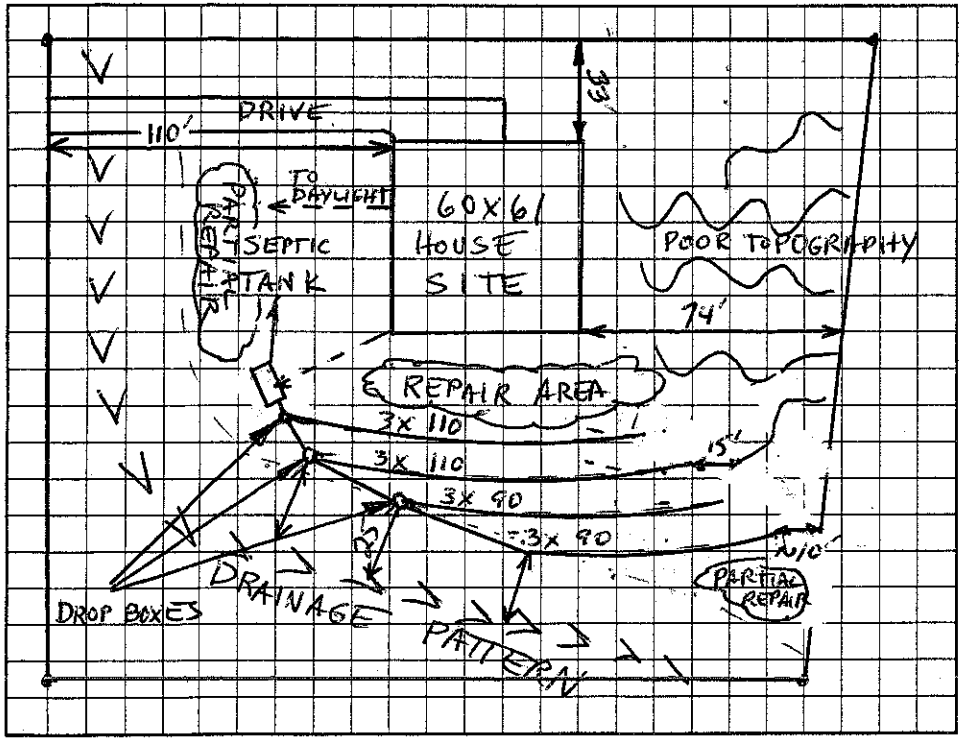

AS BUILT SKETCH

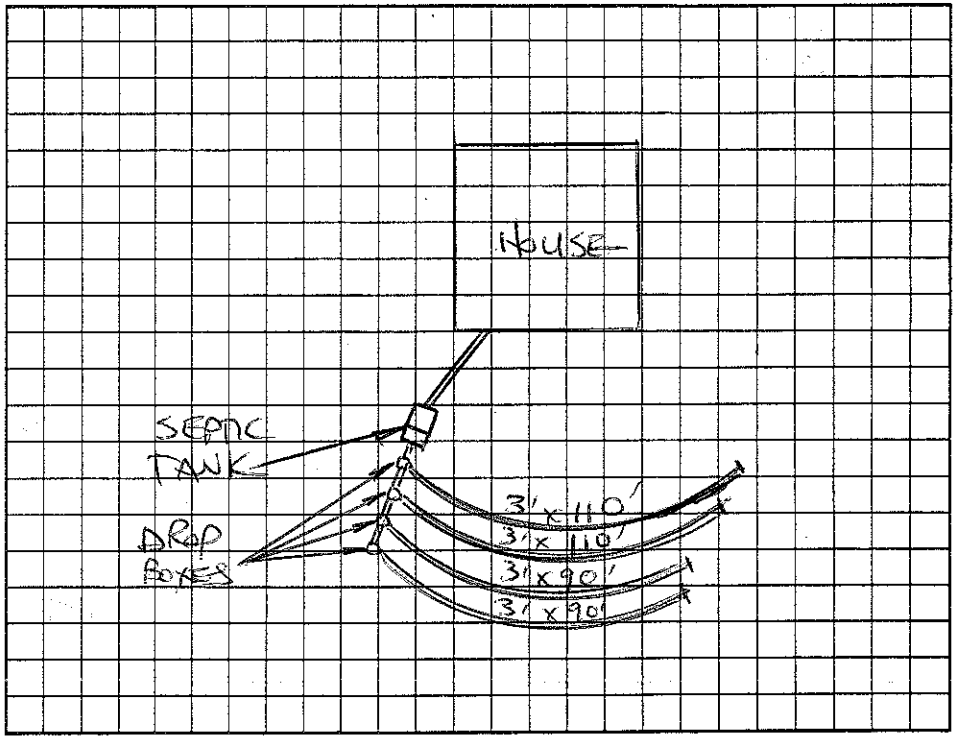

Permit can be suspended or revoked if any false information is supplied toward securing the permit/any unauthorized changes are made to the site/any unauthorized changes are made in the installation of the system. Improvement Permit with plat valid without expiration. Improvement Permit with site plan valid for sixty months. Authorization to Construct is valid for a period equal to that of Improvement Permit – not to exceed sixty months.

Signed: date 5-7-04

Improvement Permit by: Christopher M. Sherrill, RS date 5-7-04

Authorization to Construct by: Christopher M. Sherrill, RS date 5-7-04

Installed by: DAVID YOUNTZ

Operation Permit by: STEVE HEDRICK date 1-11-05

Existing System Inspection by: date

HEALTH DEPT. COPY: WHITE OWNER COPY (FINAL): YELLOW OWNER COPY (INITIAL): PINK