IREDELL COUNTY HEALTH DEPARTMENT

STATESVILLE 704-878-5305 MOORESVILLE 704-664-5281

IMPROVEMENT PERMIT / AUTHORIZATION TO CONSTRUCT / OPERATION PERMIT / EXISTING SYSTEM INSPECTION

PERMIT# REPAIR PIN# 4870 41 4868 DATE 9-27-01

OWNER OR CONTRACTOR EARLIE HAGER PHONE: Business Home (704) 876-3154

ADDRESS 524 COVE GAP RD, STATESVILLE, NC 28625

LOCATION US 21 NORTH, HOUSE ON RIGHT JUST BEFORE ROSEWOOD REST HOME AT BOX # 3052

SUBDIVISION BLOCK / SECTION LOT LOT AREA SITE CLASS PS DESIGN FLOW 600 L.T.A.R.

Septic Tank: 1000 Gallons: STB 160 Date 8-28-01

Pump Tank: Gallons: PT Date

Pump Make: Model Serial No

Nitrification Field: No Fields 4 Square Feet 1800 Linear Feet 450

No Lines FOUR Trench Width 36" Max Trench Bottom Depth 36" Gravel Depth N/A

☐ New System ☑ Repair System Type: I, II, III, IV, V, VI

System Description:

Repair System Description: 25% REDUCTION, GRAVITY

Maintenance Agreement Required: ☐ Yes ☑ No

☐ House/Mod Home No. Bedrooms

☐ Mobile Home No. Bathrooms

☐ Business No. Employees

☑ Other APARTMENTS


☐ Slab ☑ Crawl Space ☐ Basement w/plumbing ☐ Basement wo/plumbing

Water Supply: ☐ Individual ☑ Public ☐ Community


Comments/Conditions: ① INSTALL 75% CHAMBERS (AT REQUEST) IN FOUR LINES AS SHOWN ON CONTOUR ② SYSTEM TO BE REPAIRED BY 10-27-2001

Comments/Conditions: SYSTEM REPAIRED USING 59 CHAMBERS DUE TO NEIGHBORING SYSTEM LOCATION

INITIAL SITE SKETCH

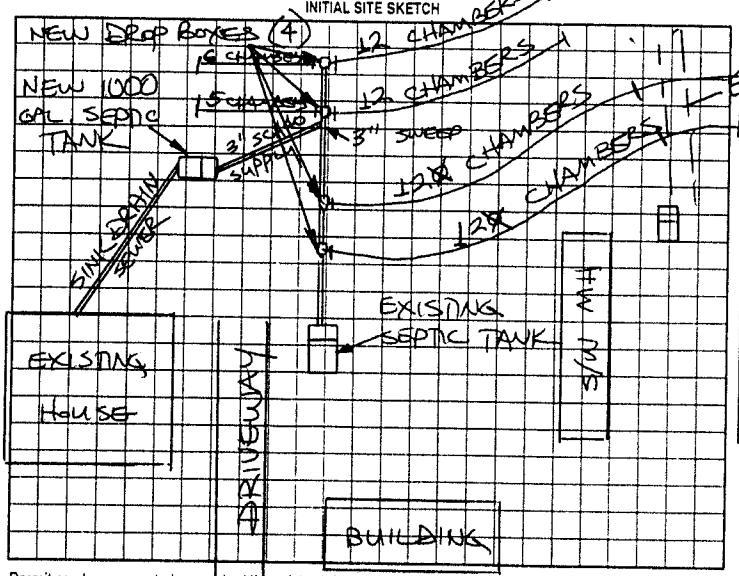

AS BUILT SKETCH

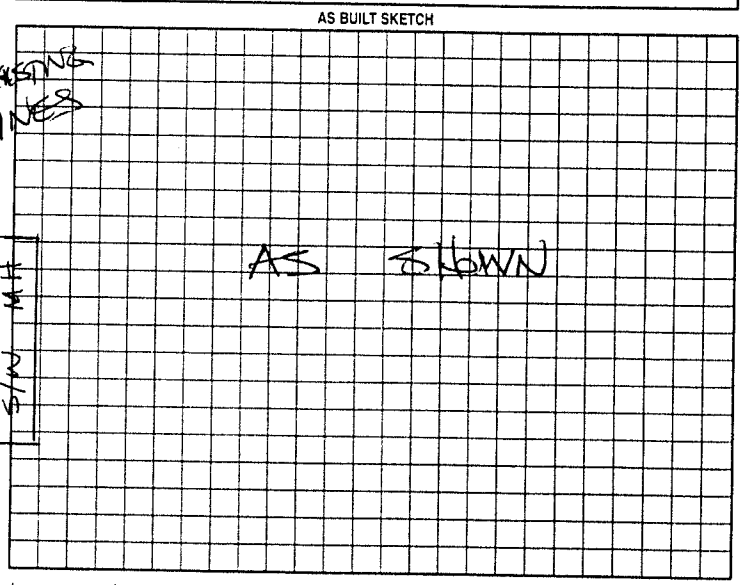

Permit can be suspended or revoked if any false information is supplied toward securing the permit/any unauthorized changes are made to the site/any unauthorized changes are made in the installation of the system. Improvement Permit with plat valid without expiration. Improvement Permit with site plan valid for sixty months. Authorization to Construct is valid for a period equal to that of Improvement Permit – not to exceed sixty months.

Signed: Earlie Hager date 9-27-01

Improvement Permit by: STEVE HEDRICK date 9-27-01

Authorization to Construct by: STEVE HEDRICK date 9-27-01

US 21 NORTH

Installed by: EARLIE HAGER / RYAN BYERS

Operation Permit by: STEVE HEDRICK date 10-22-01

Existing System Inspection by: date

HEALTH DEPT. COPY: WHITE OWNER COPY (FINAL): YELLOW OWNER COPY (INITIAL): PINK