IREDELL COUNTY HEALTH DEPARTMENT

Statesville Phone TR 3-7271 Mooresville Phone NO 3-1271

PERMIT TO INSTALL SEPTIC TANK

Permit No. _____ Permit Date Nov. 13 1964

Owner Mr. Charlie Tallibee Address Harmony

Installed By Roy Tant Address Statesville


Location of Property Just before you come to Harmony on Right at Blackstone Hwy 21

Tank		Capacity		Length of Lines		Fixtures	
Block	(✓)	1000	( )	225'	( )	No. of Baths	( )
Precast	( )	1250	( )	250'	( )	Dishwasher	( )
		1500	(✓)	Other 600 ft		Garbage Grdr.	( )
		Other _____				Other _____	

NOTIFY HEALTH DEPARTMENT AT LEAST EIGHT HOURS BEFORE TANK IS TO BE INSPECTED.

Final Inspection 11-13 1964 Approved (✓) Disapproved ( )

Remarks _____

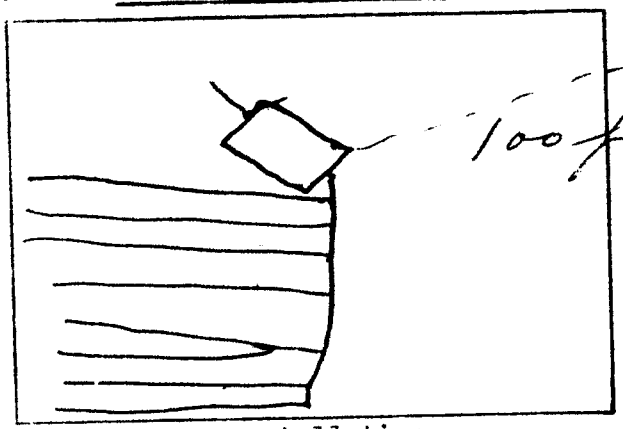

Sketch of Installation

RT

Sanitarian