IREDELL COUNTY HEALTH DEPARTMENT

Statesville Office (704) 878-5305 Mooresville Office (704) 660-3625 PERMIT # 209356

IMPROVEMENT PERMIT / AUTHORIZATION TO CONSTRUCT / OPERATION PERMIT / EXISTING SYSTEM

PIN # 4870433245

APPLICANT: Richard Hix APPLICANT ADDRESS: 348 Tatum Rd.

SITE ADDRESS: 3119 Harmony Hwy PHONE: 704-902-2245 ALT. PHONE: N/A

SITE DIRECTIONS: Hwy 21 N Property on Left across from Rosewood Rest Home

SUBDIVISION: N/A SECTION: N/A LOT # N/A LOT AREA: 1 to 2 acres DESIGN FLOW: 240gpd L.T.A.R.: Existing

Septic Tank 1000 (gal) STB 760 Date 10-4-14
Pump Tank N/A (gal) PT N/A Date N/A
Pump Make N/A Model Poly Lok Serial # PL608
Nitrification Fields 6X # Lines EX Linear Ft: EX
Trench Width EX Max. Trench Bottom Depth EX Gravel Depth EX


☐ New System ☑ Repair ☐ Expansion System Type: I (II) III IV V VI
System Description:
Repair System Description: TANK
Maintenance Agreement Required: ☐ YES ☑ NO
☐ GRAVITY ☐ PRESSURE

☑ Residence No. Bedrooms 2
☐ Business No. Persons 4
☐ Other No. Employees
☐ Slab ☑ Crawl Space
☐ Basement w/plumbing ☐ Basement w/o plumbing


Water Supply: ☐ Private ☑ Public ☐ Community

Comments / Conditions: Pump + crush existing septic tank. Install new septic tank @ location shown below + connect to existing drainfield.

INITIAL SITE SKETCH

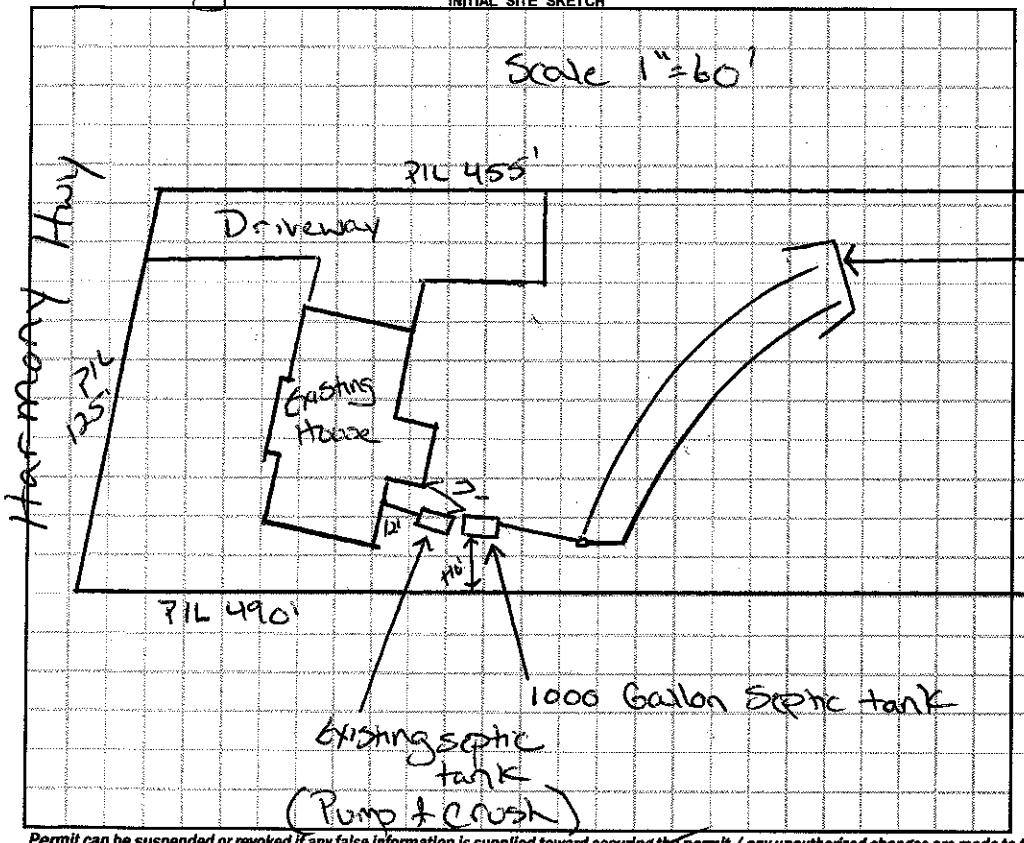

AS BUILT SKETCH

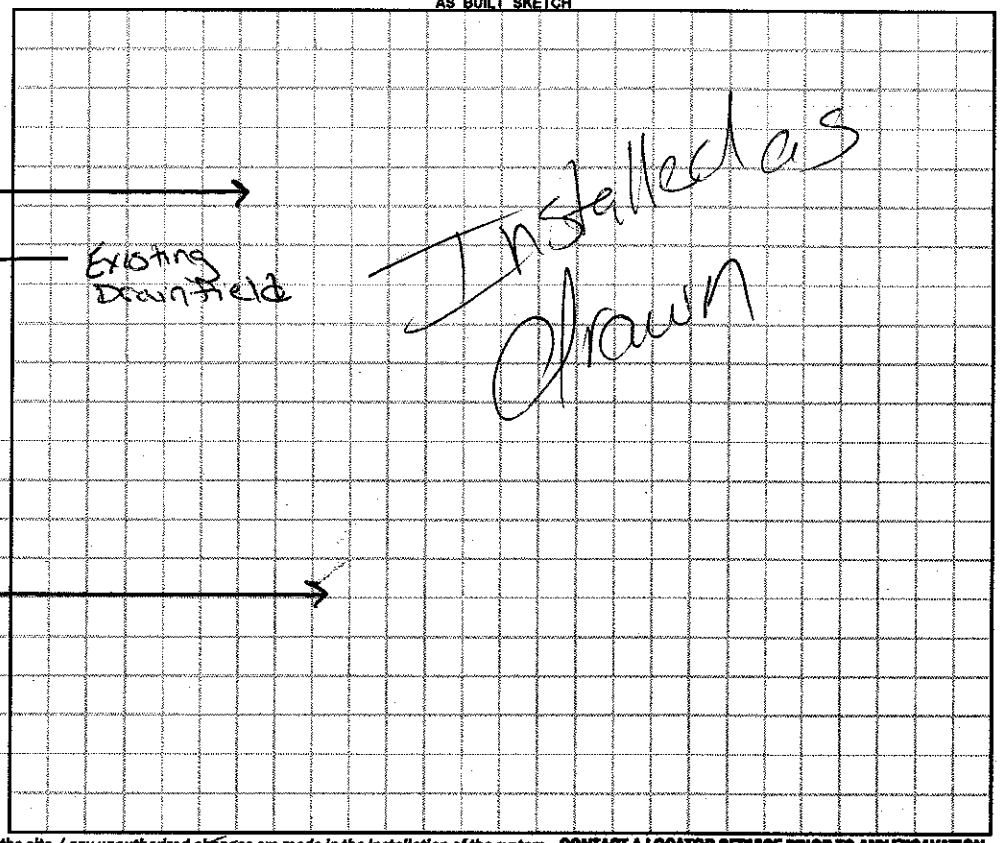

Permit can be suspended or revoked if any false information is supplied toward securing the permit / any unauthorized changes are made to the site / any unauthorized changes are made in the installation of the system. **CONTACT A LOCATOR SERVICE PRIOR TO ANY EXCAVATION**

☐ **IMPROVEMENT PERMIT** *with plat valid without expiration.* ☑ **IMPROVEMENT PERMIT** *with site plan valid for 60 mos.* ☑ **AUTHORIZATION TO CONSTRUCT** *valid for period equal to IMPROVEMENT PERMIT--not to exceed 60 mo.*

Owner / Applicant Signature: Richard Hix Date: 3-30-15 Installed by: A-1 Backhoe

IMPROVEMENT PERMIT by: Justin Rowland Date: 3-30-15 OPERATION PERMIT by: [signature] Date: 04/08/15

AUTHORIZATION TO CONSTRUCT by: Justin Rowland Date: 3-30-15 Existing System Inspected by: Date:

Health Dept. Copy - WHITE Applicant (Final Approval) - YELLOW Applicant (Conditional Approval) - PINK