IREDELL COUNTY HEALTH DEPARTMENT

STATESVILLE 704-878-5305 MOORESVILLE 704-664-5281

IMPROVEMENT PERMIT / AUTHORIZATION TO CONSTRUCT / OPERATION PERMIT / EXISTING SYSTEM INSPECTION

PERMIT# HARMONY PIN# 4870-46-4478 3439 DATE 11/22/04

OWNER OR CONTRACTOR DEREK JOHNSON PHONE: Business Home (704) 546-2997

ADDRESS 3253 HARMONY HIGHWAY HARMONY NC 28634

LOCATION US 21N TL TOMLIN RD 1/4 MILE ON LEFT

SUBDIVISION BLOCK / SECTION LOT LOT AREA 1.0 SITE CLASS. PS DESIGN FLOW 360 L.T.A.R. 0.30 gpd/ft²

Septic Tank: 1000 Gallons; STB 825 Date 11-5-04
Pump Tank: Gallons; PT Date
Pump Make: Model Serial No.
Nitrification Field: No Fields 1 Square Feet 1200' Linear Feet 400'
No Lines 4 Trench Width 36" Max Trench Bottom Depth 36" Gravel Depth 12"

☑ New System ☐ Repair System Type: I, ☐ II, III, IV, V, VI
System Description: CONVENTIONAL GRAVITY
Repair System Description: PUMP 25% REDUCTION
Maintenance Agreement Required: ☐ Yes ☑ No

☑ House/Mod. Home No. Bedrooms 3
☐ Mobile Home No. Bathrooms
☐ Business No. Employees
☐ Other


☐ Slab ☑ Crawl Space ☐ Basement w/plumbing ☐ Basement wo/plumbing

Water Supply: ☐ Individual ☑ Public ☐ Community

Comments:/Conditions: ① INSTALL LINES ON CONTOUR ② MAINTAIN ALL SETBACKS

Comments:/Conditions: ① BLUE POLYLOK FILTER ② #5 STONE

INITIAL SITE SKETCH

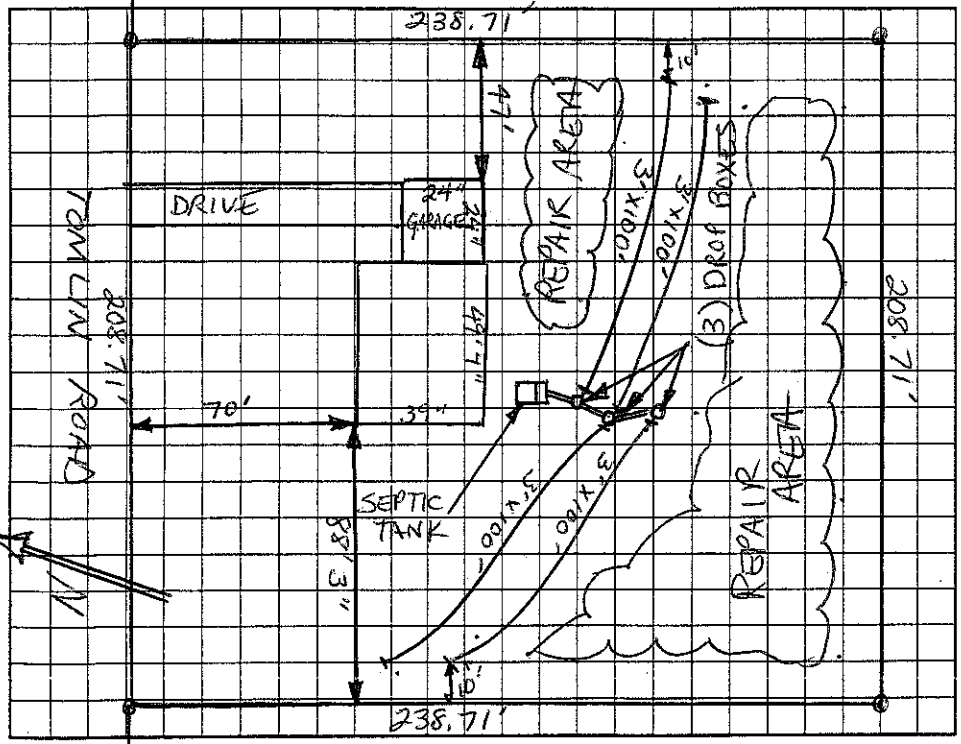

AS BUILT SKETCH

SYSTEM INSTALLED AS SHOWN

Permit can be suspended or revoked if any false information is supplied toward securing the permit/any unauthorized changes are made to the site/any unauthorized changes are made in the installation of the system. Improvement Permit with plat valid without expiration. Improvement Permit with site plan valid for sixty months. Authorization to Construct is valid for a period equal to that of Improvement Permit – not to exceed sixty months.

Signed: date 11/24/04 Installed by: ROWAN SEPTIC

Improvement Permit by: date 11/22/04 Operation Permit by: date 1-12-05

Authorization to Construct by: date 11/22/04 Existing System Inspection by: date

HEALTH DEPT. COPY: WHITE OWNER COPY (FINAL): YELLOW OWNER COPY (INITIAL): PINK