IREDELL COUNTY HEALTH DEPARTMENT

STATESVILLE 704-878-5305 MOORESVILLE 704-664-5281

IMPROVEMENT PERMIT / AUTHORIZATION TO CONSTRUCT / OPERATION PERMIT / EXISTING SYSTEM INSPECTION

PERMIT# 89231 PIN# 4870524 778 PT DATE 5/30/00

OWNER OR CONTRACTOR CHAD ALEXANDER PHONE: Business Home 546-5260

ADDRESS 3595 HARMONY HWY. HARMONY NC 28634

LOCATION 21N- TR ALEXANDER FARM- 2000' ON LT

SUBDIVISION — BLOCK / SECTION — LOT — LOT AREA ~5AC SITE CLASS. PS DESIGN FLOW L.T.A.R.

Septic Tank: 1000 Gallons; STB 760 Date 5-26-00
Pump Tank: Gallons; PT Date
Pump Make: Model Serial No.
Nitrification Field: No Fields 1 Square Feet 1200 Linear Feet 400
No Lines 3@133' Trench Width 36" Max Trench Bottom Depth 36"

☑ New System ☐ Repair System Type: I II III IV V VI
System Description: GRAVITY CONVENTIONAL
Repair System Description: SAME
Maintenance Agreement Required: ☐ Yes ☑ No


~~☑~~ House/Mod. Home No. Bedrooms 3
☐ Mobile Home No. Bathrooms 2
☐ Business No. Employees
☐ Other

Gravel Depth 12" ☐ Slab ☑ Crawl Space ☐ Basement w/plumbing ☐ Basement wo/plumbing

Water Supply: ☐ Individual ☑ Public ☐ Community


Comments:/Conditions: * NOT TO SCALE

INITIAL SITE SKETCH

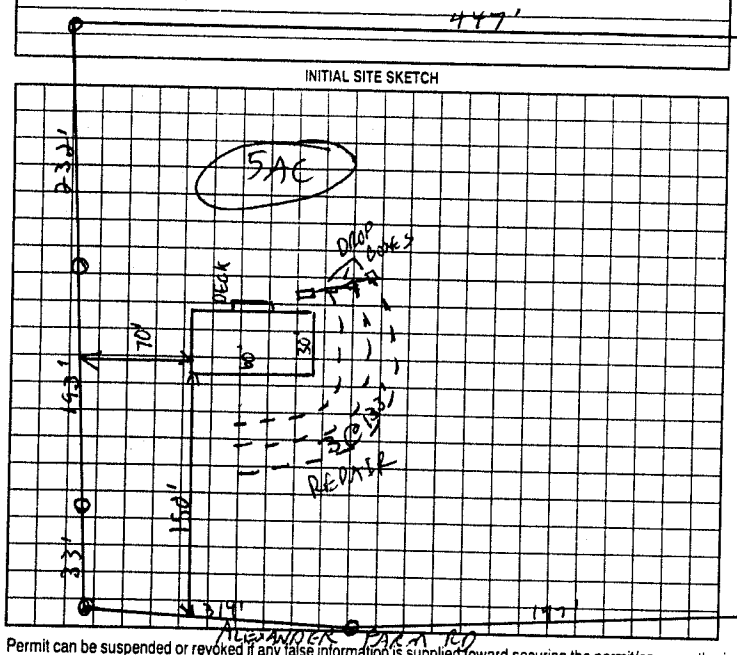

Comments:/Conditions: Installed as shown

AS BUILT SKETCH

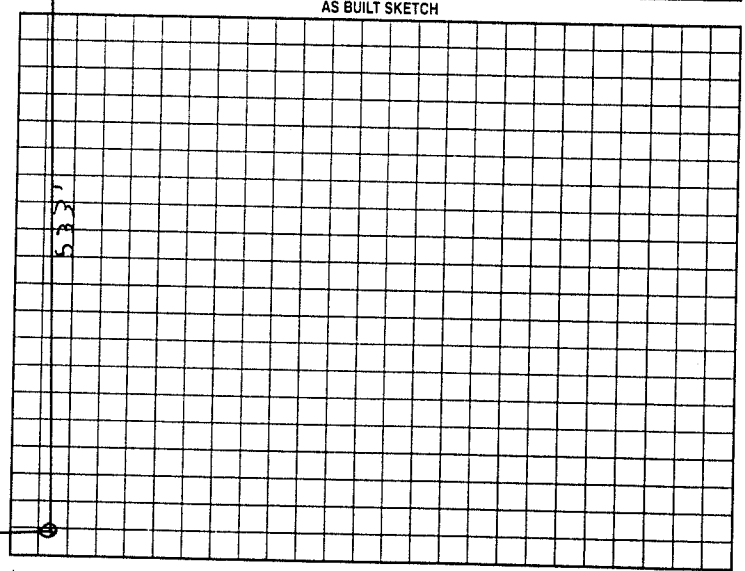

Permit can be suspended or revoked if any false information is supplied toward securing the permit/any unauthorized changes are made to the site/any unauthorized changes are made in the installation of the system. Improvement Permit with plat valid without expiration. Improvement Permit with site plan valid for sixty months. Authorization to Construct is valid for a period equal to that of Improvement Permit – not to exceed sixty months.

Signed: Laura L Alexander date

Improvement Permit by: C. Myers RS date 5/30/00

Authorization to Construct by: C. Myers RS date 5/30/00

Installed by: Brent Gyllberg

Operation Permit by: Mary C Myers RS date 9-29-00

Existing System Inspection by: date

HEALTH DEPT. COPY: WHITE OWNER COPY (FINAL): YELLOW OWNER COPY (INITIAL): PINK