IREDELL COUNTY HEALTH DEPARTMENT

STATESVILLE 704-878-5305 MOORESVILLE 704-664-5281

IMPROVEMENT PERMIT / AUTHORIZATION TO CONSTRUCT / OPERATION PERMIT / EXISTING SYSTEM INSPECTION

PERMIT# REPAIR PIN# 4870-52-2362 DATE 7-23-04

OWNER OR CONTRACTOR STUDIO ONE BLDRS. PHONE: Business (704) 902-2114 Home

ADDRESS 204 BRADLEY FARM RD. STATESVILLE 28625

LOCATION 21 N (R) ALEXANDER FARM RD (R) FERBIA LN HOUSE ON LEFT

SUBDIVISION BLOCK / SECTION LOT LOT AREA 1.03 SITE CLASS. PS DESIGN FLOW 240 L.T.A.R. EX.

Septic Tank: 1000 Gallons; STB 1012 Date 4-12-04
Pump Tank: 1000 Gallons; PT 17 Date 4-19-04
Pump Make: GOULDS Model WE03111M Serial No. G04606402
Nitrification Field: No Fields 1 Square Feet Linear Feet 210
No Lines 3 Trench Width 36" Max Trench Bottom Depth 36" Gravel Depth 24"

☐ New System ☑ Repair System Type: I (II) III, IV, V, VI
System Description:
Repair System Description: CONVENTIONAL PUMP
Maintenance Agreement Required: ☐ Yes ☑ No

☑ House/Mod. Home No. Bedrooms 2
☐ Mobile Home No. Bathrooms 1
☐ Business No. Employees
☐ Other

☐ Slab ☐ Crawl Space ☐ Basement w/plumbing ☐ Basement wo/plumbing


Water Supply: ☐ Individual ☑ Public ☐ Community IREDELL WATER

Comments/Conditions: ① INSTALL SYSTEM ON CONTOUR ② REROUTE WM PLUMBING INTO NEW TANK ③ PUMP, CRUSH, AND FILL OLD TANK ④ RECOMMEND REMOVAL OF LARGE PEAR TREE ⑤ THIS PERMIT SERVES AS A 30-DAY NOV AND MUST BE REPAIRED WITHIN THAT TIME FRAME


Comments/Conditions: ① TUFF TITE ② #57 ③ PEAR TREE REMOVED ④ 18" RISER

SCALE 1" = 50'

INITIAL SITE SKETCH

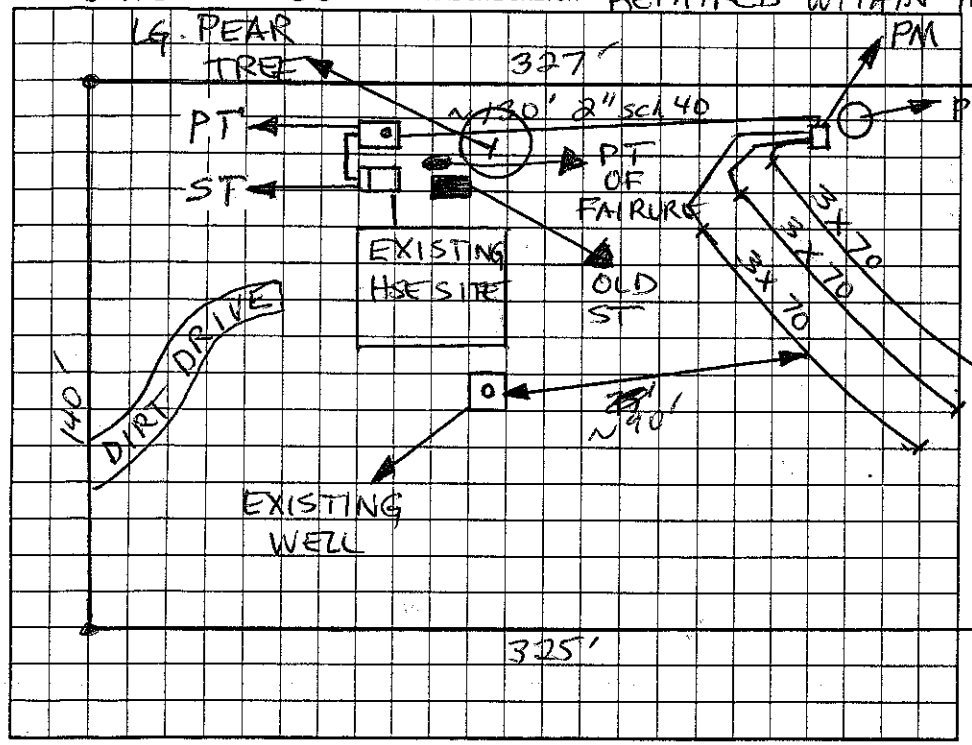

AS BUILT SKETCH

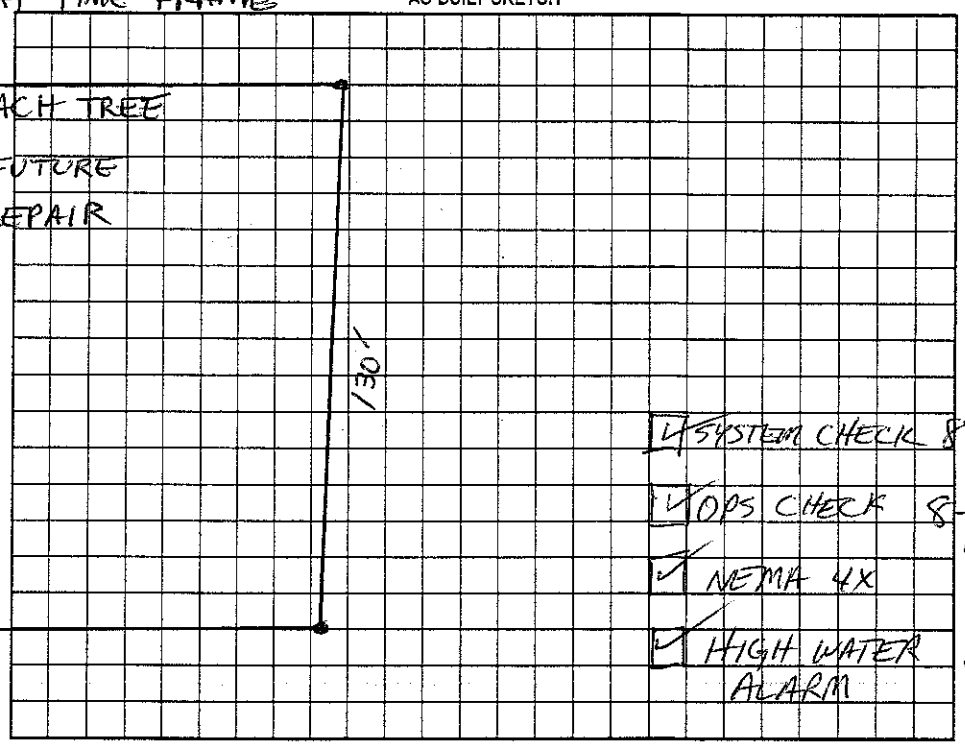

☑ SYSTEM CHECK 8-25-04
☑ OPS CHECK 8-26-04
☑ NEMA 4X
☑ HIGH WATER ALARM

Permit can be suspended or revoked if any false information is supplied toward securing the permit/any unauthorized changes are made to the site/any unauthorized changes are made in the installation of the system. Improvement Permit with plat valid without expiration. Improvement Permit with site plan valid for sixty months. Authorization to Construct is valid for a period equal to that of Improvement Permit – not to exceed sixty months.

Signed: [signature] date 8/2/2004 Installed by: PIEDMONT BACKHOE

Improvement Permit by: Christopher M. Shue, LRS date 7-23-04 Operation Permit by: Christopher M. Shue, LRS date 8-26-04

Authorization to Construct by: Christopher M. Shue, LRS date 7-23-04 Existing System Inspection by: date

HEALTH DEPT. COPY: WHITE OWNER COPY (FINAL): YELLOW OWNER COPY (INITIAL): PINK