IREDELL COUNTY HEALTH DEPARTMENT

STATESVILLE 704-878-5305 MOORESVILLE 704-664-5281

IMPROVEMENT PERMIT / CERTIFICATE OF COMPLETION / OPERATION PERMIT / EXISTING SYSTEM INSPECTION

PROPERTY DESCRIPTION NO. 23691 DATE 5-11-96 TAX MAP NO. 12N-A-179 Watershed: ☐ Yes ☑ No

OWNER OR CONTRACTOR CHAD ALEXANDER PHONE: Business Home 546-5260

ADDRESS 3595 HARMONY HWY HARMONY, NC 28634

LOCATION US 21 N, TR ALEXANDER FARM RD 1ST MH ON LEFT

SUBDIVISION BLOCK / SECTION LOT LOT AREA 10 ACRES SITE CLASS PS DESIGN FLOW 240 L.T.A.R. EXISTING

Septic Tank: 1000 Gallons; STB Date

Pump Tank: Gallons; PT Date

Pump Make: Model Serial No.

Nitrification Field: No Fields 1 Square Feet 750 Linear Feet 250

No Lines 2 Trench Width Max Trench Bottom Depth Gravel Depth 10"

☐ New System ☐ Repair System Type: I (II) III IV V VI

System Description: CONVENTIONAL GRAVITY

Repair System Description:

Maintenance Agreement Required: ☐ Yes ☑ No

☑ House/Mod. Home ☑ Mobile Home ☐ Business ☐ Other

No. Bedrooms 2 No. Bathrooms 2 No. Employees


☐ Slab ☐ Crawl Space ☐ Basement w/plumbing ☐ Basement wo/plumbing

Water Supply: ☐ Individual ☐ Community ☑ Public


Comments:

Comments: KEEP MH FOUNDATION MINIMUM 5' FROM SEPTIC TANK

INITIAL SITE SKETCH

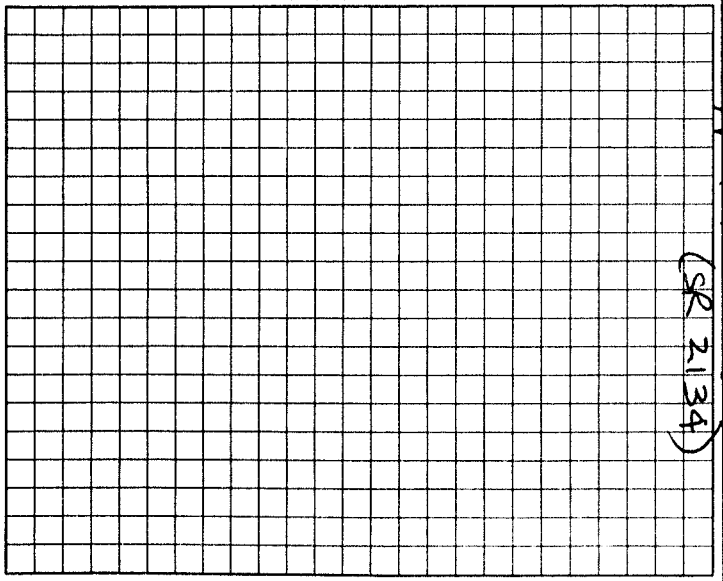

AS BUILT SKETCH

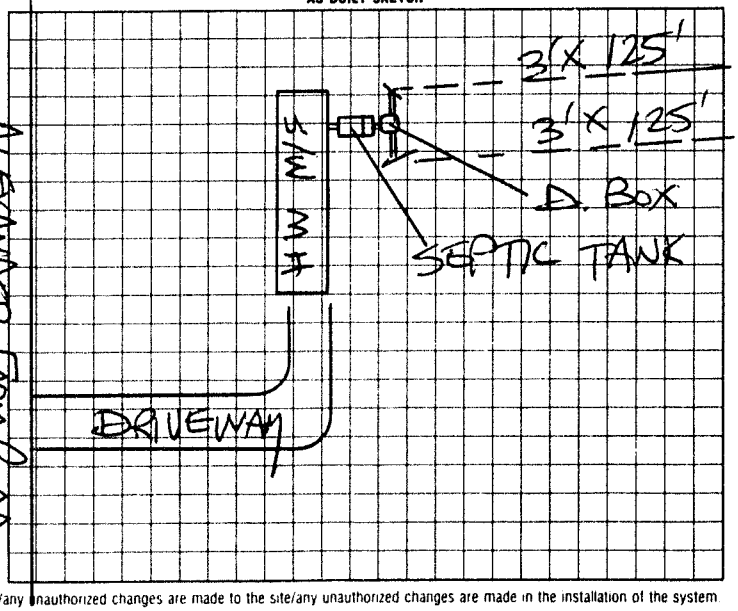

I understand that this permit can be suspended or revoked if any false information is supplied toward securing the permit/any unauthorized changes are made to the site/any unauthorized changes are made in the installation of the system.

Signed:

Improvement Permit by: date

Existing System Inspection by: STEVE HEDRICK date 5-11-96

Installed by

Certificate of Completion by date

Operation Permit by date

HEALTH DEPT. COPY WHITE INSPECTION COPY (FINAL) GREEN OWNER COPY (FINAL) YELLOW INSPECTION COPY (INITIAL) PINK OWNER COPY (INITIAL) GOLD