000006

IREDELL COUNTY HEALTH DEPARTMENT

STATESVILLE 704-878-5305 MOORESVILLE 704-664-5281

IMPROVEMENT PERMIT / AUTHORIZATION TO CONSTRUCT / OPERATION PERMIT / EXISTING SYSTEM INSPECTION

PERMIT# REPAIR PIN# DATE 11-17-98

OWNER OR CONTRACTOR CHARLIE RAGGARLY PHONE: Business Home 546-2119

ADDRESS 3124 HARMONY HIGHWAY, HARMONY, NC 28634

LOCATION US 21 NORTH, ON RIGHT NEXT TO ROSEWOOD AT BOX # 3124

SUBDIVISION BLOCK / SECTION LOT LOT AREA AMPLE SITE CLASS PS DESIGN FLOW 360 L.T.A.R EXISTING

Septic Tank: EXISTING Gallons: STB Date

Pump Tank: Gallons: PT Date

Pump Make: Model Serial No

Nitrification Field: No Fields 1 Square Feet 180 Linear Feet 60

No Lines ONE Trench Width 36" Max Trench Bottom Depth 42" Gravel Depth 12"+

☐ New System ☑ Repair System Type: I II III IV V VI

System Description:

Repair System Description: CONV. GRAVITY

Maintenance Agreement Required: Yes

☑ House/Mod. Home No. Bedrooms 3

☐ Mobile Home No. Bathrooms 2

☐ Business No. Employees

☐ Other


Slab ☑ Crawl Space ☐ Basement w/ plumbing ☐ Basement w/o plumbing

Water Supply: ☐ Individual ☑ Public ☐ Community

Comments/Conditions: THIS PERMIT SERVES AS NOTICE OF VIOLATION

Comments/Conditions:

INITIAL SITE SKETCH

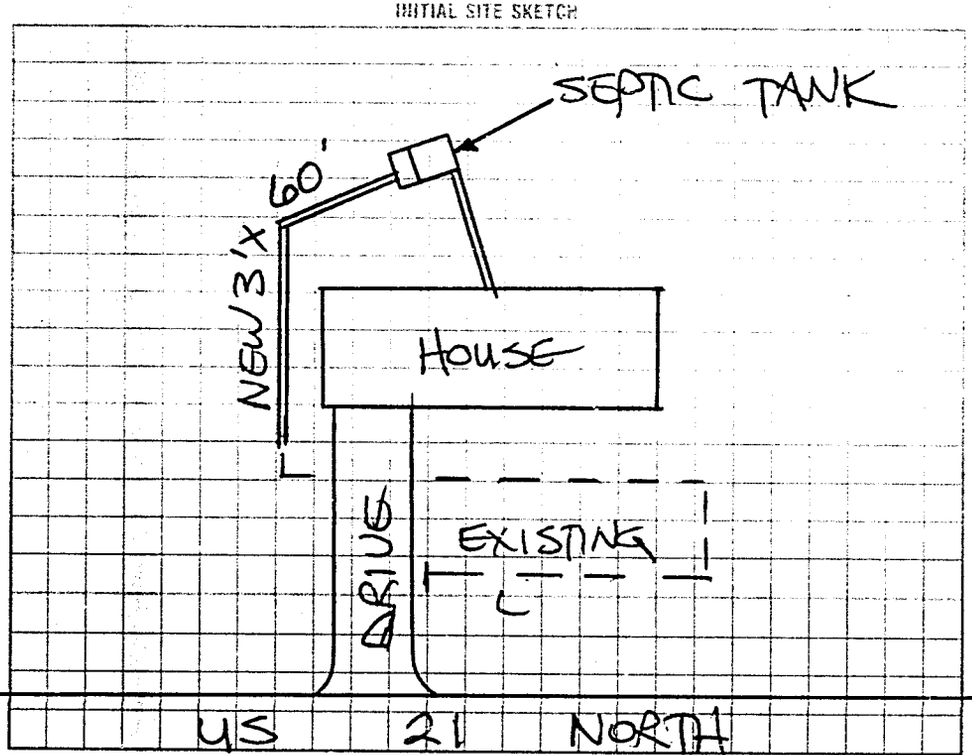

AS BUILT SKETCH

SYSTEM REPAIRED ACCORDING TO INITAL SITE SKETCH

I understand that this permit can be suspended or revoked if any false information is supplied toward securing the permit/any unauthorized changes are made to the site/any unauthorized changes are made in the installation of the system. Improvement Permit with plat valid without expiration. Improvement Permit with site plan valid for sixty months. Authorization to Construct is valid for a period equal to that of Improvement Permit – not to exceed sixty months.

Signed: + Charlie L Baggarly date 11-17-98 Installed by: SAMMY REAVIS

Improvement Permit by: STEVE HEDRICK date 11-17-98 Operation Permit by: STEVE HEDRICK date 11-18-98

Authorization to Construct by: STEVE HEDRICK date 11-17-98 Existing System Inspection by: date

HEALTH DEPT. COPY: WHITE INSPECTION COPY (FINAL): GREEN OWNER COPY (FINAL): YELLOW INSPECTION COPY (INITIAL): PINK OWNER COPY (INITIAL): GOLD