IREDELL COUNTY HEALTH DEPARTMENT

STATESVILLE 704-878-5305 MOORESVILLE 704-664-5281

IMPROVEMENT PERMIT / CERTIFICATE OF COMPLETION / OPERATION PERMIT / EXISTING SYSTEM INSPECTION

PROPERTY DESCRIPTION NO. REPAIR DATE 6/29/93 TAX MAP NO. REPAIR

OWNER OR CONTRACTOR CHARLIE BAGGARLY PHONE: Business Home 546-2119

ADDRESS RT 2 BOX 82, HARMONY, NC 28634

LOCATION US 21 N, ON (R), JUST SOUTH OF ROSEWOOD BEST HOME IN HARMONY

SUBDIVISION BLOCK / SECTION LOT LOT AREA AMPLE SITE CLASS. PS L.T.A.R. EXISTING

Water Supply: ☐ Individual ☐ Community ☑ Public

Septic Tank: EXISTING Gallons: STB Date

Pump Tank: Gallons: PT Date

Nitrification Field: No Fields 1 Square Feet 420± Linear Feet 70± EXISTING LINES

No Lines 1 Trench Width 72" Trench Depth 36" Gravel Depth 18"

☐ New System ☑ Repair System Type: I. II (III) IV. V. VI

System Description:

Repair System Description: CONV. GRAVITY

Maintenance Agreement Required: ☐ Yes ☐ No

☑ House/Mod. Home No. Bedrooms 3

☐ Mobile Home No. Bathrooms 2

☐ Business No. Employees

☐ Other

Garbage Disposal: ☐ Yes ☑ No

Auto. Dishwasher: ☐ Yes ☐ No


Auto. Washing Machine: ☑ Yes ☐ No

Other


☐ Slab ☐ Crawl Space ☐ Basement w/plumbing ☑ Basement wo/plumbing

Comments ① TANK WAS PUMPED 6/29/93, IN GOOD INTEGRITY.
② USE 3" SCH 40 PIPE FROM TANK TO LOCATION SHOWN
③ TIE IN KITCHEN/WASHER PIPE AS SHOWN ④ INSTALL NEW 6' x 70' BED ON CONTOUR, NO DEEPER THAN 36", 18" STONE

INITIAL SITE SKETCH

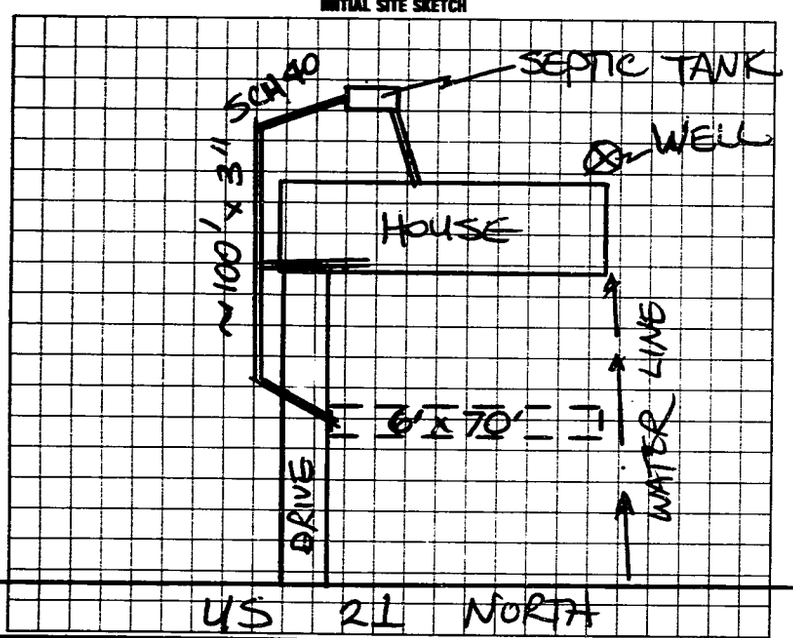

AS BUILT SKETCH

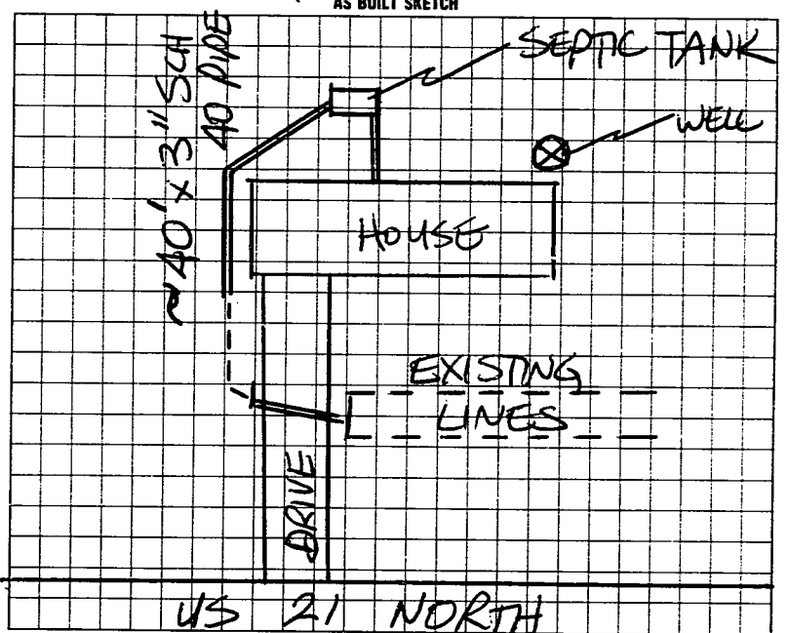

I understand that this permit can be suspended or revoked if any false information is supplied toward securing the permit/any unauthorized changes are made to the site/any unauthorized changes are made in the installation of the system. Improvement Permit is valid for 60 months from date of issuance.

Signed: X Charlie Baggarly

Improvement Permit by: STEVE HEDRICK date 6/29/93

Existing System Inspection by: date

Installed by: SAMMY REAVIS

Certificate of Completion by: STEVE HEDRICK date 7/8/93

Operation Permit by: date

HEALTH DEPT. COPY: WHITE INSPECTION COPY (FINAL): GREEN OWNER COPY (FINAL): YELLOW INSPECTION COPY (INITIAL): PINK OWNER COPY (INITIAL): GOLD