IREDELL COUNTY HEALTH DEPARTMENT

STATESVILLE 704-878-5305 MOORESVILLE 704-664-5281

IMPROVEMENT PERMIT / AUTHORIZATION TO CONSTRUCT / OPERATION PERMIT / EXISTING SYSTEM INSPECTION

PERMIT# REPAIR PIN#

OWNER OR CONTRACTOR RUSSELL COLLINS PHONE: Business Home 546-7046 DATE 2-15-99

ADDRESS 3283 HARMONY HIGHWAY HARMONY NC 28634

LOCATION US 21 N. APX TO HARMONY, GO HOUSE ON LEFT PAST GALAXY AT BOX # 3283

SUBDIVISION BLOCK / SECTION LOT LOT AREA UNLIMITED SITE CLASS PS DESIGN FLOW 360 L.T.A.R. EXISTING

Septic Tank: EXISTING Gallons: STB Date

Pump Tank: Gallons: PT Date

Pump Make: Model Serial No.

Nitrification Field: No Fields 1 Square Feet 300 Linear Feet 100

No Lines 1 Trench Width 36" Max Trench Bottom Depth 36"± Gravel Depth 24"

☐ New System ☑ Repair System Type: I II III IV V VI

System Description:

Repair System Description: CONV. GRAVITY

Maintenance Agreement Required: Yes No

Slab ☑ Crawl Space Basement w/plumbing Basement wo/plumbing

☑ House/Mod. Home No. Bedrooms

Mobile Home No. Bathrooms

Business No. Employees


Other

Water Supply: ☐ Individual ☑ Public ☐ Community WELL

Comments/Conditions: ① REPLACE SANITARY TEE IN SEPTIC TANK IF NECESSARY ② PIPE ALL GUTTER DRAINS AWAY FROM SYSTEM ③ TIE WASHER DRAIN INTO SYSTEM ④ USE 3"x10' SCH 40 UNDER SIDEWALK

Comments Conditions

INITIAL SITE SKETCH

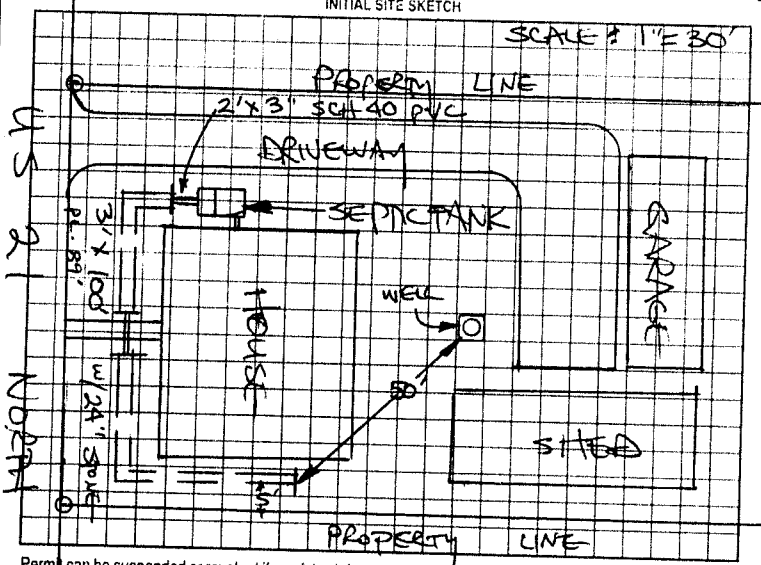

AS BUILT SKETCH

SYSTEM REPAIRED ACCORDING TO INITIAL SITE SKETCH

Permit can be suspended or revoked if any false information is supplied toward securing the permit/any unauthorized changes are made to the site/any unauthorized changes are made in the installation of the system. Improvement Permit with plat valid without expiration. Improvement Permit with site plan valid for sixty months. Authorization to Construct is valid for a period equal to that of Improvement Permit - not to exceed sixty months.

Signed: + Russell Collins date 2/15/99

Improvement Permit by: STEVE HEDRICK date 2-15-99

Authorization to Construct by: STEVE HEDRICK date 2-15-99

Installed by: SAMMY KEAHS

Operation Permit by: STEVE HEDRICK date 2-23-99

Existing System Inspection by: date

HEALTH DEPT COPY WHITE OWNER COPY (FINAL) YELLOW OWNER COPY (INITIAL) PINK