IREDELL COUNTY HEALTH DEPARTMENT

Statesville Phone TR 3-7271 Mooresville Phone NO 3-1271

PERMIT TO INSTALL SEPTIC TANK

Permit NO. _____ Permit Date 8-14 1963

Owner HARMONY CAFE Address HARMONY, N.C.

Installed By _____ Address CITY OF TALBERT


Location of Property HARMONY, N.C.

Tank		Capacity		Length of Lines		Fixtures	
Block	(X)	800	( )	150'	( )	No. of Baths	( )
Precast	( )	900	( )	175'	( )	Dishwasher	( )
		1000	( )	200'	( )	Garbage Grdr.	( )
		1100	( )	225'	( )	Auto-Washer	( )
		1200	( )	250'	( )	Other	
		Other 2200		Other 15X50 250 sq. ft.			

NOTIFY HEALTH DEPARTMENT AT LEAST EIGHT HOURS BEFORE TANK IS TO BE INSPECTED.

Final Inspection 8-14 1963 Approved (✓) Disapproved ( )

Remarks _____

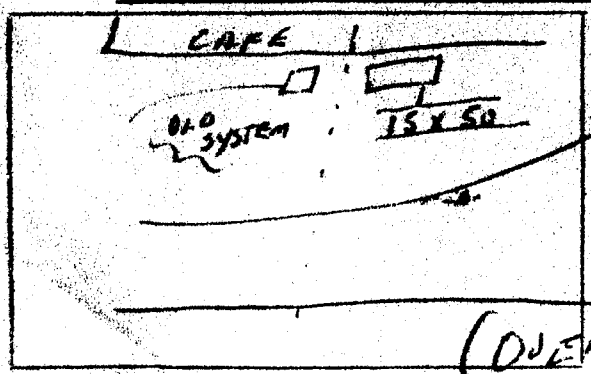

(OVER)

Sketch of Installation

Sanitarian