IREDELL COUNTY HEALTH DEPARTMENT

STATESVILLE 704-878-5305 MOORESVILLE 704-664-5281

IMPROVEMENT PERMIT / AUTHORIZATION TO CONSTRUCT / OPERATION PERMIT / EXISTING SYSTEM INSPECTION

PERMIT# REPAIR PIN# 4870-57-7898 DATE 11-27-06

OWNER OR APPLICANT F.S. GAITHER ET AL PHONE: Business Home

ADDRESS 3306 HARMONY HWY HARMONY, NC 28634

LOCATION US 21 NORTH, ON RIGHT, JUST PAST NC 901 AT BOX # 3348

SUBDIVISION BLOCK / SECTION LOT LOT AREA LIMITED SITE CLASS. PS DESIGN FLOW 200 L.T.A.R. 0.30 GPD/FT2

Septic Tank: EXISTING Gallons: STB Date

Pump Tank: Gallons: PT Date

Pump Make: Model Serial No.

Nitrification Field: No Fields 1 Square Feet 420 Linear Feet 140

No Lines ONE Trench Width 36" Max Trench Bottom Depth 36"+/- Gravel Depth 12"

☐ New System ☑ Repair ☐ Expansion System Type: I (II) III IV V VI

System Description:

Repair System Description: CONVENTIONAL, GRAVITY

Maintenance Agreement Required: ☐ Yes ☒ No

☐ House/Mod. Home No. Bedrooms

☐ Mobile Home No. Persons

☒ Business No. Employees 8

☐ Other POST OFFICE


Water Supply: ☐ Individual ☒ Public ☐ Community

☑ Gravity ☐ Pressure ☑ Slab ☐ Crawl Space ☐ Basement w/plumbing ☐ Basement wo/plumbing


Comments/Conditions: ① INSTALL NEW SANITARY TEE IN SEPTIC TANK ② INSTALL NEW 3' X 140' LINE AS SHOWN ③ AN "ACCEPTA" SYSTEM MAY ALSO BE USED.

Comments/Conditions: ④ CHECK SEPTIC TANK FOR INTEGRITY, REPLACE IF NECESSARY (1000 GAL.)! + New "Tee" added

INITIAL SITE SKETCH ~ SCALE: 1" = 40'

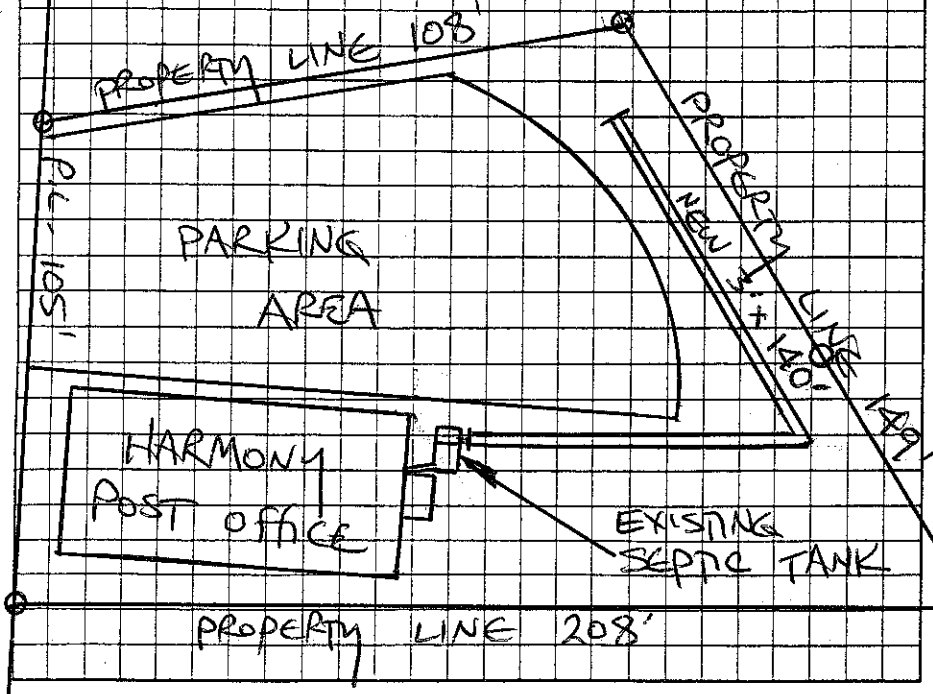

AS BUILT SKETCH

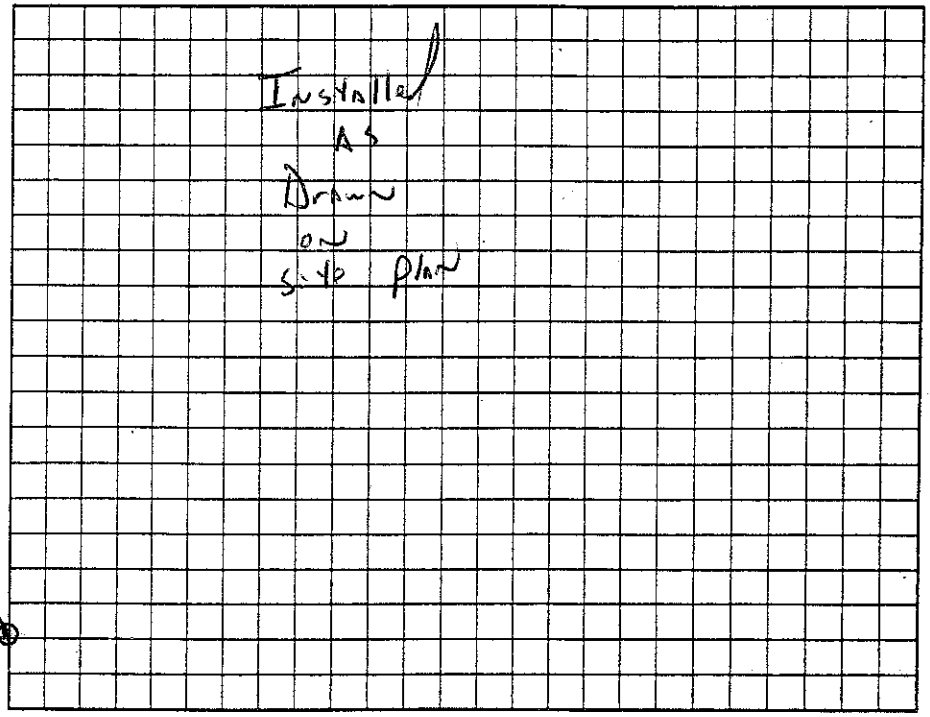

US 21 NORTH

Permit can be suspended or revoked if any false information is supplied toward securing the permit/any unauthorized changes are made to the site/any unauthorized changes are made in the installation of the system. Improvement Permit with ~~plat~~ valid without expiration ☐ Improvement Permit with site plan valid for sixty months ☑ Authorization to Construct is valid for a period equal to that of Improvement Permit – not to exceed sixty months.

Signed: Darrell Gaither date 11-27-2006 Installed by: Sammy Reavis

Improvement Permit by: STEVE HEDRICK date 11-27-06 Operation Permit by: Jim Hogan, R.S. date 20 December 06

Authorization to Construct by: STEVE HEDRICK date 11-27-06 Existing System Inspection by: date

HEALTH DEPT. COPY: WHITE OWNER COPY (FINAL): YELLOW OWNER COPY (INITIAL): PINK