IREDELL COUNTY HEALTH DEPARTMENT

STATESVILLE 704-878-5305 MOORESVILLE 704-664-5281

IMPROVEMENT PERMIT / AUTHORIZATION TO CONSTRUCT / OPERATION PERMIT / EXISTING SYSTEM INSPECTION

PERMIT# REPAIR PIN# DATE 9-20-00

OWNER ~~OR CONTRACTOR~~ RICK E. MONEY PHONE: Business Home 546-3388

ADDRESS 120 MEMORIAL HWY, HARMONY NC 28634

LOCATION US 21 NORTH, TR NC 901, 1ST HOUSE ON RIGHT (BESIDE FIRE ~~DEPARTMENT~~)

SUBDIVISION BLOCK / SECTION LOT LOT AREA LIMITED SITE CLASS PS DESIGN FLOW 240 L.T.A.R. EXISTING

Septic Tank: ~~EXISTING~~ Gallons; STB 760 Date 7-10-00

Pump Tank: 1000 Gallons; PT Date

Pump Make: Model Serial No.

Nitrification Field: No Fields 1 Square Feet 450 Linear Feet 150

No Lines THREE Trench Width 36" Max Trench Bottom Depth 36" Gravel Depth 24"

☐ New System ☑ Repair System Type: ☐ II, ☐ IV, ☐ V, ☐ VI

System Description: CONVENTIONAL GRAVITY

Repair System Description: CONV. GRAVITY

Maintenance Agreement Required: ☐ Yes ☐ ~~No~~

☐ Slab ☐ Crawl Space ☐ Basement w/plumbing ☑ ~~Basement~~ wo/plumbing

☐ House/Mod. Home No. Bedrooms 2

☐ Mobile Home No. Bathrooms 1

☐ Business No. Employees


☐ Other

Water Supply: ☐ Individual ☐ Public ☐ Community

Comments/Conditions: PUMP-OUT SEPTIC TANK, REPLACE SANITARY TEE IF NECESSARY

Comments/Conditions: SEPTIC TANK W/ MARKER INSTALLED USING "ZABEL" FILTER

INITIAL SITE SKETCH

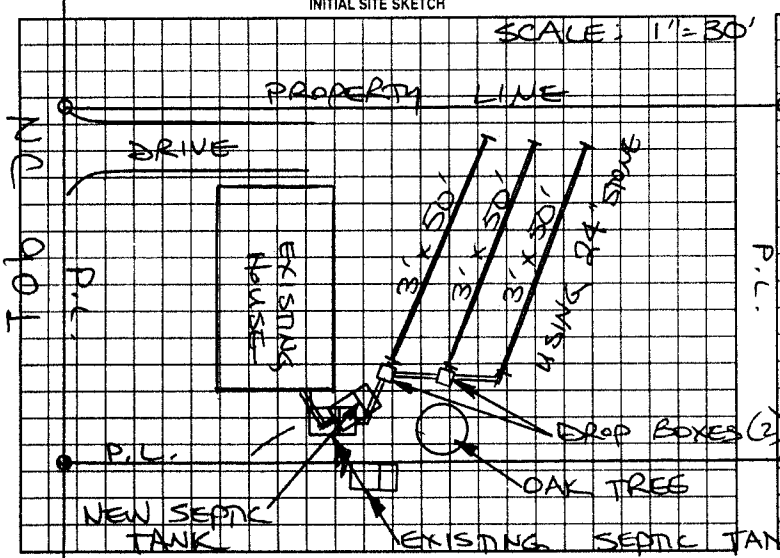

AS BUILT SKETCH

SYSTEM REPAIRED ACCORDING TO INITIAL SITE SKETCH

Permit can be suspended or revoked if any false information is supplied toward securing the permit/any unauthorized changes are made to the site/any unauthorized changes are made in the installation of the system. Improvement Permit with plat valid without expiration. Improvement Permit with site plan valid for sixty months. Authorization to Construct is valid for a period equal to that of Improvement Permit – not to exceed sixty months.

Signed: Rick E Money date

Installed by: BRENT GALLIHER

Improvement Permit by: STEVE HEDRICK date 9-20-00

Operation Permit by: STEVE HEDRICK date 10-2-00

Authorization to Construct by: STEVE HEDRICK date 9-20-00

Existing System Inspection by: date

HEALTH DEPT COPY: WHITE OWNER COPY (FINAL) YELLOW OWNER COPY (INITIAL): PINK