IREDELL COUNTY HEALTH DEPARTMENT

Statesville Phone TR 3-7271 Mooresville Phone NO 3-1271

PERMIT TO INSTALL SEPTIC TANK

Permit NO. _____ Permit Date February 24th 1958

Owner Baptist Parsonage Address Harmony, N.C.

Installed By CLYDE HOKE Address Charlotte Hwy, Statesville


Location of Property In Harmony - 2nd house (Statesville) side of Reavis Funeral Home.

Tank		Capacity		Length of Lines		Fixtures	
Block	( )	800	( )	150'	(✓)	No. of Baths	(1)
Precast	( )	900	( )	175'	( )	Dishwasher	( )
EXISTING		1000	(✓)	200'	( )	Garbage Grdr.	( )
		1100	( )	225'	( )	Auto-Washer	( )
		1200	( )	250'	( )	Other	
		Other		Other			

NOTIFY HEALTH DEPARTMENT AT LEAST EIGHT HOURS BEFORE TANK IS TO BE INSPECTED.

Final Inspection February 24th 1958 Approved (X) Disapproved ( )

Remarks Tapped into old lines - some use of old lines expected.

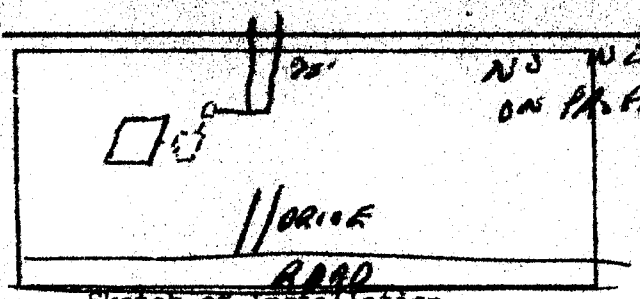

Sketch of Installation

Rayford A. Thomas

Sanitarian