IREDELL COUNTY HEALTH DEPARTMENT

STATESVILLE 704-878-5305 MOORESVILLE 704-664-5281

IMPROVEMENT PERMIT / AUTHORIZATION TO CONSTRUCT / OPERATION PERMIT / EXISTING SYSTEM INSPECTION

PERMIT# REPAIR PIN# DATE 11-30-99

OWNER OR CONTRACTOR REAVIS FUNERAL HOME, HARMONY PHONE: Business 546-2626 Home 873-7223 (BILL PORTER)

ADDRESS P.O. BOX 85, HARMONY, NC 28634

LOCATION US 21 NORTH, TO HARMONY, PAST NC 901, FUNERAL HOME ON LEFT

SUBDIVISION BLOCK / SECTION LOT LOT AREA LIMITED SITE CLASS PS DESIGN FLOW ~275 L.T.A.R. 0.30 GPD/FT²

Septic Tank: EXISTING Gallons; STB Date

Pump Tank: Gallons; PT Date

Pump Make: Model Serial No.

Nitrification Field: No Fields 2 Square Feet 900 Linear Feet 300

No Lines 5IX Trench Width 36" Max Trench Bottom Depth 30" Gravel Depth 12"

☒ New System ☒ Repair System Type: I (II) III IV V VI

System Description: CONVENTIONAL GRAVITY

Repair System Description: CONVENTIONAL GRAVITY

Maintenance Agreement Required: ☐ Yes ☒ No

☐ House/Mod. Home ☐ Mobile Home ☒ Business ☐ Other FUNERAL HOME

No. Bedrooms 2 No. Bathrooms 3 No. Employees


☐ Slab ☒ Crawl Space ☐ Basement w/plumbing ☐ Basement wo/plumbing

Water Supply: ☐ Individual ☒ Public ☐ Community


Comments:/Conditions: ① INSTALL NEW SANITARY TEE IN SEPTIC TANK ② INSTALL NEW FLOW DIVIDER TEE AT OUTLET FEEDING TWO SERIES OF BOOB BOXES FEEDING THREE LINES EACH ③ INSTALL LINES ON CONTOUR AS FLAGGED ON SITE

Comments:/Conditions:

INITIAL SITE SKETCH

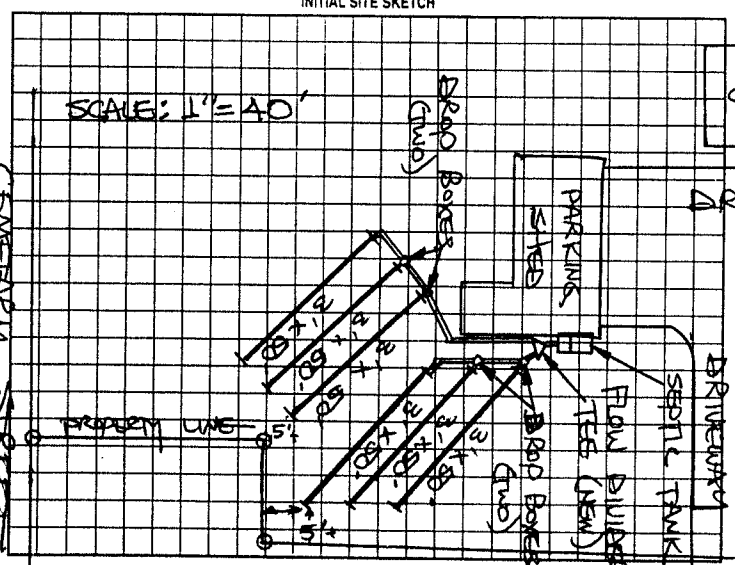

AS BUILT SKETCH

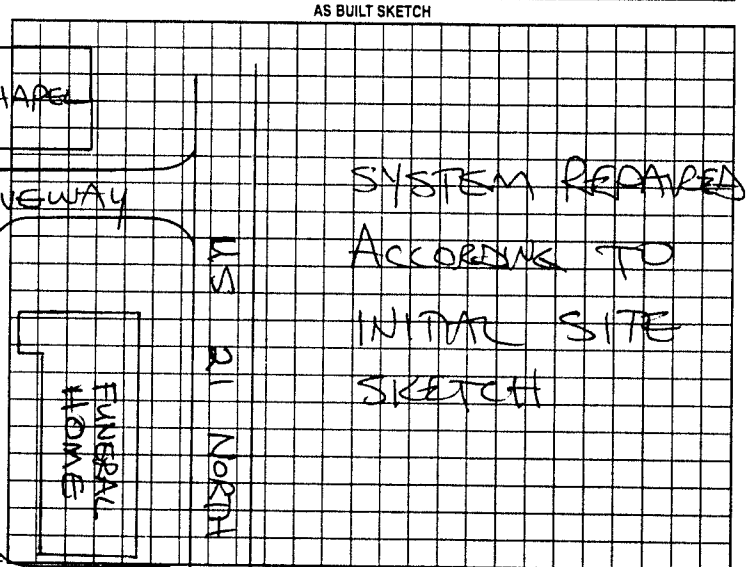

Permit can be suspended or revoked if any false information is supplied toward securing the permit/any unauthorized changes are made to the site/any unauthorized changes are made in the installation of the system. Improvement Permit with plat valid without expiration. Improvement Permit with site plan valid for sixty months. Authorization to Construct is valid for a period equal to that of Improvement Permit – not to exceed sixty months.

Signed: Ralph Hooks date 11-30-99 Installed by: TOMMY FRYE

Improvement Permit by: STEVE HENDRICK date 11-30-99 Operation Permit by: STEVE HENDRICK date 8-30-00

Authorization to Construct by: STEVE HENDRICK date 11-30-99 Existing System Inspection by: date

HEALTH DEPT. COPY: WHITE OWNER COPY (FINAL): YELLOW OWNER COPY (INITIAL): PINK