IREDELL COUNTY HEALTH DEPARTMENT

STATESVILLE 704-878-5305 MOORESVILLE 704-664-5281 (C1)

IMPROVEMENT PERMIT / AUTHORIZATION TO CONSTRUCT / OPERATION PERMIT / EXISTING SYSTEM INSPECTION

PERMIT# 148636 PIN# 4870-58-8250 DATE 3-6-08

OWNER OR APPLICANT FIRST BANK CORP. PHONE: Business c/o 919-833-7336 x210 Home

ADDRESS 3364 HARMONY HWY, HARMONY NC 28634

LOCATION US 21 NORTH, ON RIGHT IN HARMONY AT # 3364

SUBDIVISION BLOCK / SECTION LOT LOT AREA 0.196 ACRE SITE CLASS. PS DESIGN FLOW 225 L.T.A.R. EXISTING

Septic Tank: 1000 Gallons; STB Date

Pump Tank: Gallons; PT Date

Pump Make: Model Serial No.

Nitrification Field: No Fields 1 Square Feet 750 Linear Feet 250

No Lines THREE Trench Width 36" Max Trench Bottom Depth DEEP Gravel Depth 10"

☐ New System ☐ Repair ☐ Expansion System Type: I II III IV V VI

System Description: CONVENTIONAL, GRAVITY

Repair System Description:

Maintenance Agreement Required: ☐ Yes ☒ No

☐ Gravity ☐ Pressure

☐ House/Mod. Home No. Bedrooms

☐ Mobile Home No. Persons

☒ Business No. Employees 9

☐ Other BANK W/ 9 PERSONS

Water Supply: ☐ Individual ☒ Public ☐ Community


☐ Slab ☐ Crawl Space ☐ Basement w/plumbing ☐ Basement wo/plumbing

Comments:/Conditions:


Comments:/Conditions: GRADE AREA OVER DRAINFIELD TO A UNIFORM SLOPE TO PREVENT PONDING

~SCALE: 1"=50' (THIS IS NOT A SURVEY)

INITIAL SITE SKETCH

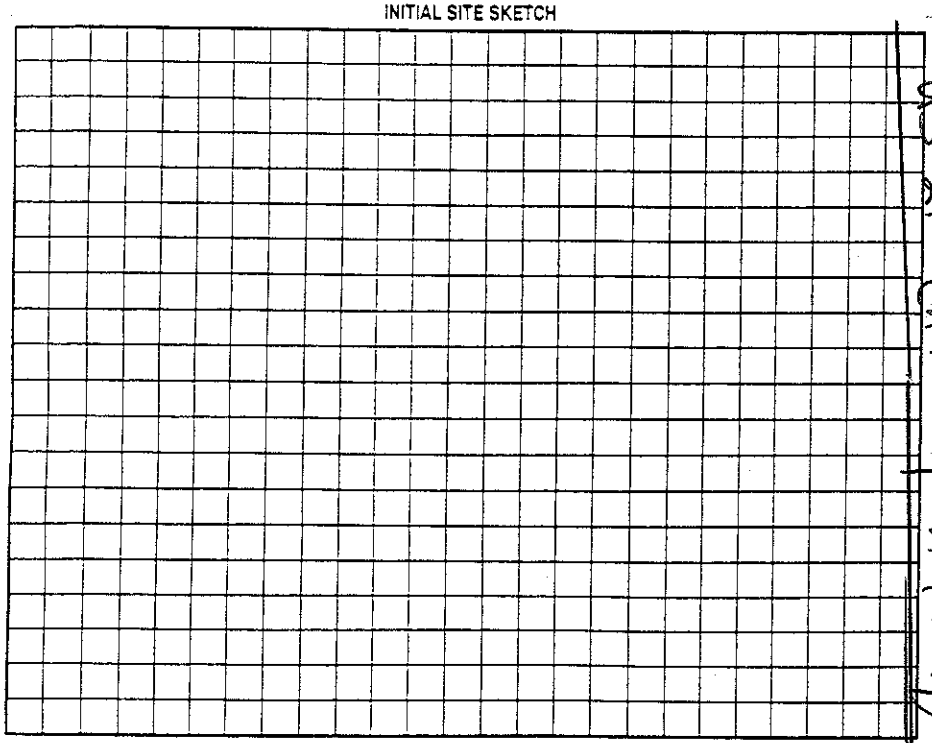

AS BUILT SKETCH

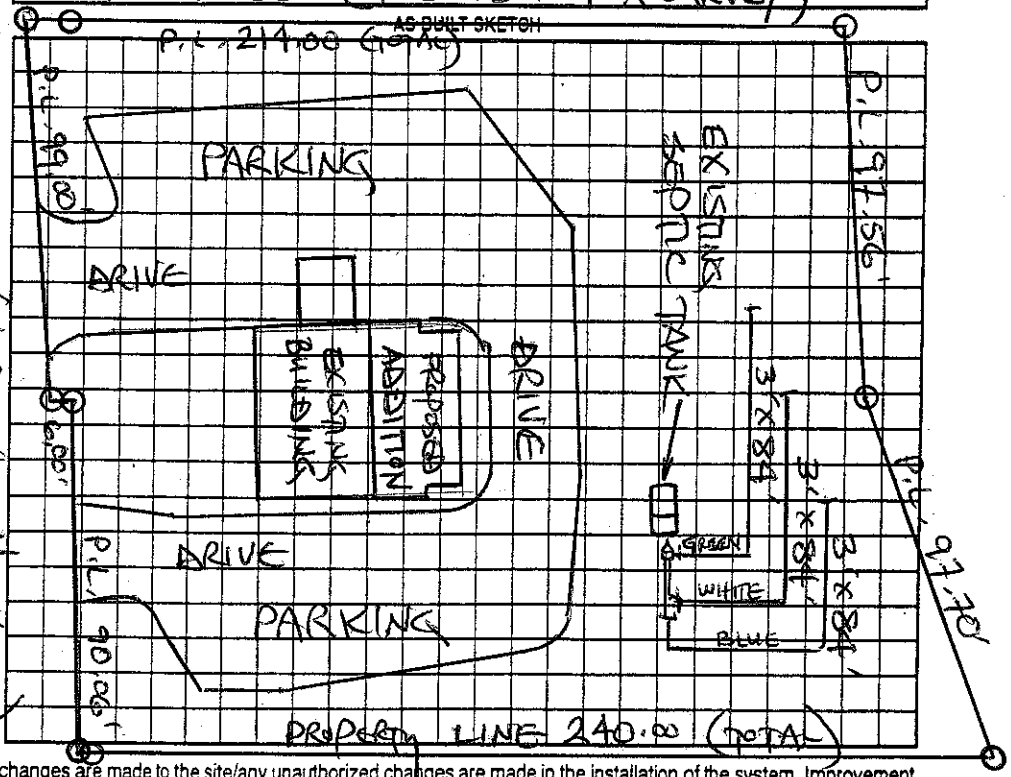

Permit can be suspended or revoked if any false information is supplied toward securing the permit/any unauthorized changes are made to the site/any unauthorized changes are made in the installation of the system. Improvement Permit with plat valid without expiration ☐ Improvement Permit with site plan valid for sixty months ☐ Authorization to Construct is valid for a period equal to that of Improvement Permit – not to exceed sixty months.

Signed: date

Improvement Permit by: date

Authorization to Construct by: date

Installed by:

Operation Permit by: date

Existing System Inspection by: STEVE HEDRICK date 3-6-08

HEALTH DEPT. COPY: WHITE OWNER COPY (FINAL): YELLOW OWNER COPY (INITIAL): PINK