IREDELL COUNTY HEALTH DEPARTMENT

THIS PERMIT VOIDS PREVIOUS ISSUED 8-31-00

STATESVILLE 704-878-5305 MOORESVILLE 704-664-5281

IMPROVEMENT PERMIT / AUTHORIZATION TO CONSTRUCT / OPERATION PERMIT / EXISTING SYSTEM INSPECTION

PERMIT# 091518 PIN# 4870-52-8538 // 4870-62-1597 DATE 5-9-02

OWNER OR CONTRACTOR JOHN D. ALEXANDER PHONE Business 704-902-2365 Home 704-546-2263

ADDRESS 3589 HARMONY HWY, HARMONY NC 28634

LOCATION US 21 NORTH, TR ALEXANDER FARM ROAD, 0.3 MILE ON LEFT

SUBDIVISION _____ BLOCK / SECTION _____ LOT _____ LOT AREA 10 ACRES SITE CLASS PS DESIGN FLOW 360 LTAR 0.30 GPD/FT²

Septic Tank: 1000 Gallons. STB 760 Date 3-1-02
Pump Tank: _____ Gallons. PT _____ Date _____
Pump Make: _____ Model _____ Serial No _____
Nitrification Field: No Fields 1 Square Feet 1200 Linear Feet 400
No Lines FOUR Trench Width 36" Max Trench Bottom Depth 36" Gravel Depth 12"

New System ✓ Repair System Type I II III IV V
System Description CONVENTIONAL, GRAVITY
Repair System Description 25% REDUCTION, GRAVITY
Maintenance Agreement Required Yes No


House/Mod. Home No. Bedrooms 3
Mobile Home No. Bathrooms 2
Business No. Employees _____
Other _____
Slab Crawl Space Basement w/plumbing ✓ Basement wo/plumbing

Water Supply: ☐ Individual ✓ Public ☐ Community

Comments./Conditions: KEEP SYSTEM MINIMUM TEN FEET FROM WATER LINE

Comments./Conditions: SEPTIC TANK WITH MARKER INSTALLED USING "ZABEL" FILTER

INITIAL SITE SKETCH

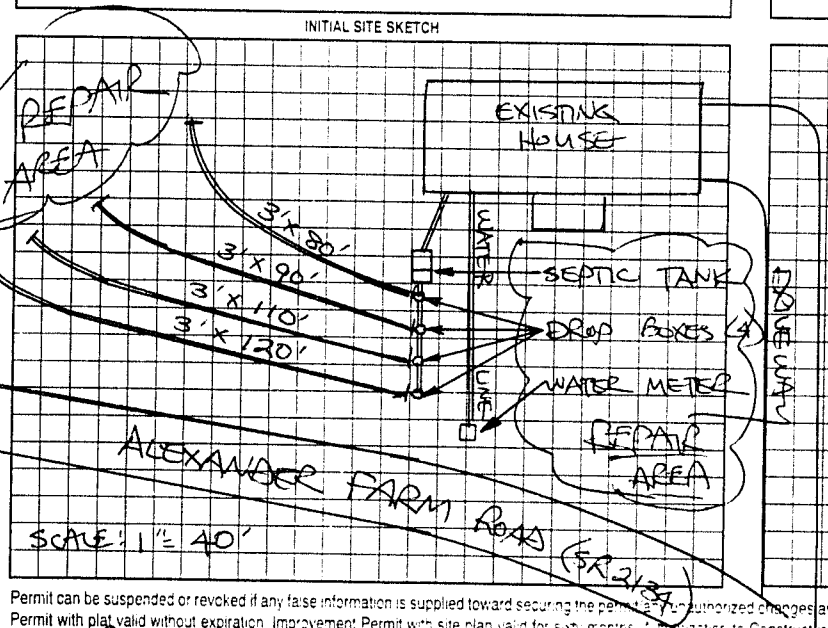

AS BUILT SKETCH

SYSTEM INSTALLED ACCORDING TO INITIAL SITE SKETCH

Permit can be suspended or revoked if any false information is supplied toward securing the permit, any unauthorized changes are made to the site, any unauthorized changes are made in the installation of the system. Improvement Permit with plat valid without expiration. Improvement Permit with site plan valid for sixty months. Authorization to Construct is valid for a period equal to that of Improvement Permit – not to exceed sixty months.

Signed: Colleen Alexander date _____ Installed by BRENT GALLIHER

Improvement Permit by: STEVE HENDRICK date 5-9-02 Operation Permit by STEVE HENDRICK date 6-21-02

Authorization to Construct by: STEVE HENDRICK date 5-9-02 Existing System Inspection by _____ date _____

HEALTH DEPT COPY WHITE OWNER COPY (FINAL) YELLOW OWNER COPY (INITIAL) PINK