IREDELL COUNTY HEALTH DEPARTMENT

STATESVILLE 704-878-5305 MOORESVILLE 704-664-5281

IMPROVEMENT PERMIT / AUTHORIZATION TO CONSTRUCT / OPERATION PERMIT / EXISTING SYSTEM INSPECTION

PERMIT # 157460 PIN # 4870-64-8511 DATE 22 July 09

OWNER or APPLICANT Willie Kennedy PHONE: Business Home: 704-546-2572

OWNER or APPLICANT ADDRESS 535 Crawfish Rd. Harmony, N.C. 28634

LOCATION / DIRECTIONS Hwy 21N TR 901 TR Crawfish rd. .3 mile on Rt.

SUBDIVISION BLOCK / SECTION LOT # LOT AREA 7.46ac. DESIGN FLOW 360 gpd L.T.A.R. 0.3 gpd/ft²

Septic Tank	1000	Gallons: STB	760	Date	5-16-09	☑ New System	☐ Repair	☐ Expansion System	Type I II III IV V VI	☑ Residence	No. Bedrooms 3	Water Supply
Pump Tank		Gallons: P T		Date		System Description: ~~25% Reduction System~~ Conv.				☐ Business	No. Persons	☐ Private
Pump Make		Model		Serial #		Repair System Description: 25% Reduction System				☐ Other	No. Employees	☑ Public
Nitrification Field	No Fields 1	No Lines 4	Linear Feet ~~300~~ 400			Maintenance Agreement Required	☐ YES	☑ NO		☐ Slab	☑ Crawl Space	☐ Community
Trench Width	36"	Max. Trench Bottom Depth	36"	Gravel Depth	~~12"~~	☑ GRAVITY	☐ PRESSURE			☐ Basement w/plumbing	☐ Basement w/o plumbing	


Comments / Conditions: Follow contour / Keep 50' from all wells / * 12" of Gravel.

Comments / Conditions

INITIAL SITE SKETCH

* Please see Attached Site Sketch.

AS BUILT SKETCH

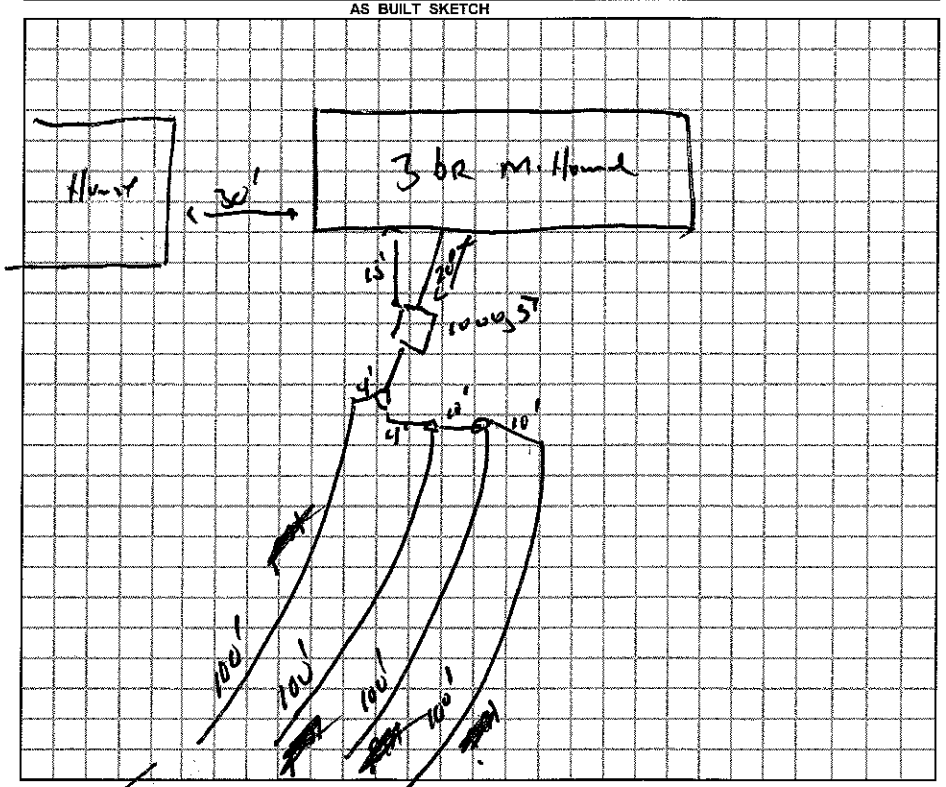

Permit can be suspended or revoked if any false information is supplied toward securing the permit / any unauthorized changes are made to the site / any unauthorized changes are made in the installation of the system.

☐ *IMPROVEMENT PERMIT w / plat valid without expiration* ☑ *IMPROVEMENT PERMIT w / site plan valid for 60 mos.* ☑ *AUTHORIZATION TO CONSTRUCT valid for period equal to IMPROVEMENT PERMIT-not to exceed 60 mo.*

Owner / Applicant Signature: + Willie Kennedy Date

Improvement Permit by: [signature], R.S. Date 22 Jul 09

Authorization to Construct by: [signature], R.S. Date 22 Jul 09

Installed by: Sammy Reavis

Operation Permit by: [signature], R.S. Date: 4 August 09

Existing System Inspected by: Date:

YOU SHOULD CONTACT A LOCATOR SERVICE PRIOR TO ANY EXCAVATION.

WHITE COPY Environmental Health YELLOW COPY (Final) Owner / Applicant PINK COPY (Initial) Owner / Applicant