Not on BT. Called Sanitarian

IREDELL COUNTY HEALTH DEPARTMENT

Statesville Phone TR 3-7271 Mooresville Phone NO 3-1271

PERMIT TO INSTALL SEPTIC TANK

Permit No. _____ Permit Date 5-18 19 70

Owner Piedmont Garment Co. Address Harmony, N.C.

Installed By Lackey Bros. Const. Co. Address Rt. 1 Stony Point, N.C.


Location of Property In Harmony Turn right on 901, first factory on left.

Tank		Capacity		Length of Lines		Fixtures	
Block	( )	1000	( )	225'	( )	No. of Baths	( )
Precast	( )	1250	( )	~~250~~ 300	(✓)	Dishwasher	( )
		1500	( )	Other _____		Garbage Grdr.	( )
		Other _____				Other _____	

NOTIFY HEALTH DEPARTMENT AT LEAST EIGHT HOURS BEFORE TANK IS TO BE INSPECTED.

Final Inspection _____ 19___ Approved ( ) Disapproved ( )

Remarks repaired drain line 300 Ft.

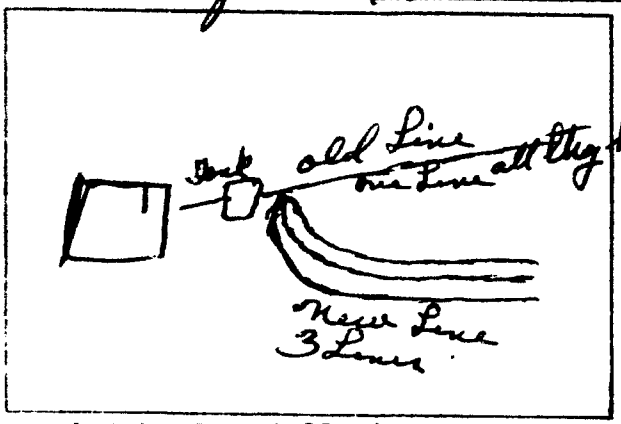

Sketch of Installation

Sanitarian