IREDELL COUNTY HEALTH DEPARTMENT

STATESVILLE 704-878-5305 MOORESVILLE 704-664-5281

IMPROVEMENT PERMIT / CERTIFICATE OF COMPLETION / OPERATION PERMIT / EXISTING SYSTEM INSPECTION

PROPERTY DESCRIPTION NO. REPAIR DATE 9/20/94 TAX MAP NO. REPAIR Watershed: ☐ Yes ☒ No

OWNER OR CONTRACTOR MYRTLE BURGESS PHONE: Business Home 546-7593

ADDRESS 148 WOODLAND BENA HARMONY NC 28634

LOCATION US 21 N, TR WOODLAND BEND, BEAR (R) THEN (L), HOUSE ON (R)

SUBDIVISION BLOCK / SECTION LOT LOT AREA AMPLE SITE CLASS. DESIGN FLOW 240 L.T.A.R. EXISTING

Septic Tank: EXISTING Gallons; STB Date

Pump Tank: Gallons; PT Date

Pump Make: Model Serial No.

Nitrification Field: No Fields 1 Square Feet 780 Linear Feet 260

No Lines 2 Trench Width 36" Max Trench Bottom Depth 18-36" Gravel Depth 12"

☐ New System ☑ Repair System Type: I, (II), III, IV, V, VI

System Description: CONV. GRAVITY

Repair System Description: CONV. GRAVITY

Maintenance Agreement Required: ☐ Yes ☒ No

☑ House/Mod. Home No. Bedrooms 2

☐ Mobile Home No. Bathrooms 2

☐ Business No. Employees

☐ Other


☐ Slab ☑ Crawl Space ☐ Basement w/plumbing ☐ Basement wo/plumbing

Water Supply: ☐ Individual ☐ Community ☒ Public

Comments: (1) INSTALL NEW DIST. BOXES AS SHOWN (2) CHECK TANK FOR SANITARY "TEE", REPLACE IF NECESSARY (3) INSTALL NEW LINES AS SHOWN ON CONTOUR, NO DEEPER THAN 36", 9' O.C.-MIN.

Comments:

INITIAL SITE SKETCH

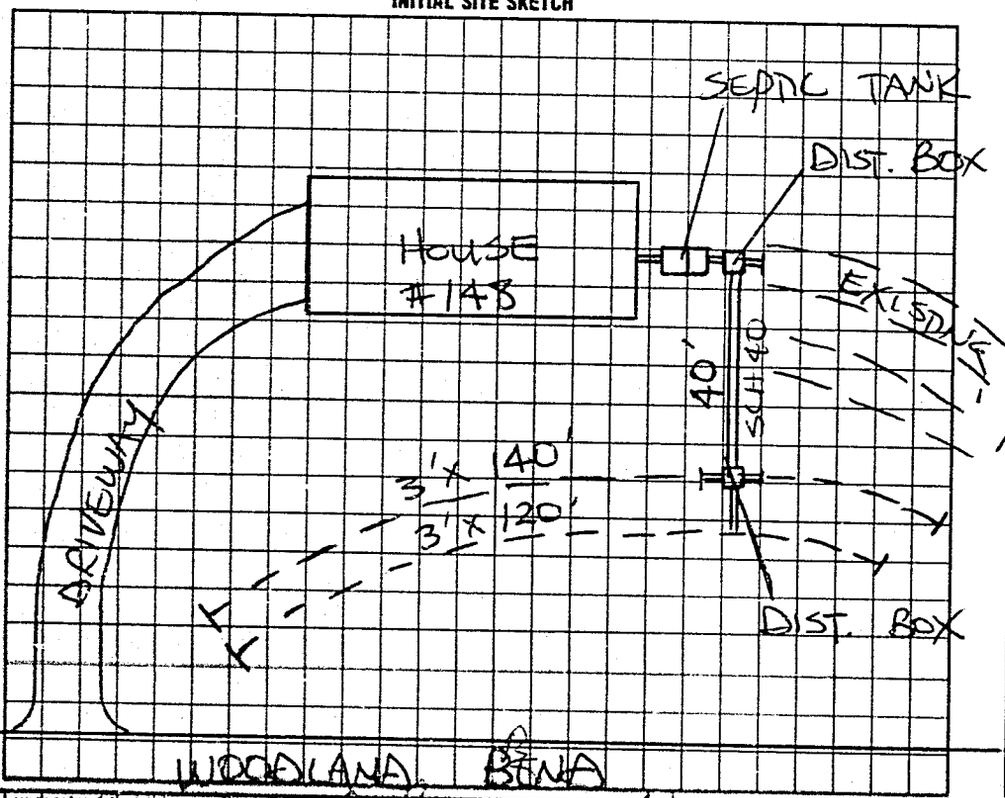

AS BUILT SKETCH

SYSTEM REPAIRED ACCORDING TO INITIAL SITE SKETCH

I understand that this permit can be suspended or revoked if any false information is supplied toward securing the permit/any unauthorized changes are made to the site/any unauthorized changes are made in the installation of the system. Improvement Permit is valid for 60 months from date of issuance.

Signed:

Improvement Permit by: STEVE HEDRICK date 9/20/94

Existing System Inspection by: date

Installed by: SAMMY REVIS

Certificate of Completion by: STEVE HEDRICK date 9/22/94

Operation Permit by: date

HEALTH DEPT. COPY: WHITE INSPECTION COPY (FINAL): GREEN OWNER COPY (FINAL): YELLOW INSPECTION COPY (INITIAL): PINK OWNER COPY (INITIAL): GOLD